Redlined Color Elevation

WEST ELEVATION LEMOORE AVE.

LEMOORE RETAIL

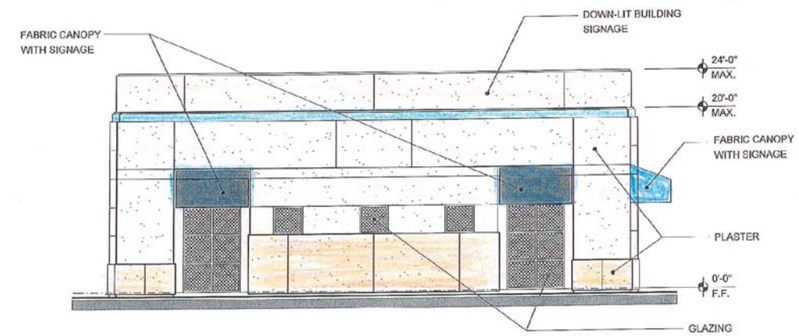

NORTH ELEVATION MAGNOLIA AVE.

RECEIVED
FEB 24 2012
PLANNING DEPT.

LEMOORE RETAIL

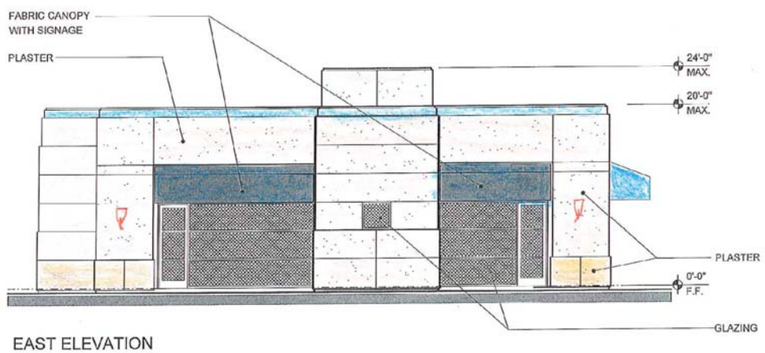

EAST ELEVATION

RECEIVED
FEB 24 2012
PLANNING DEPT.

LEMOORE RETAIL

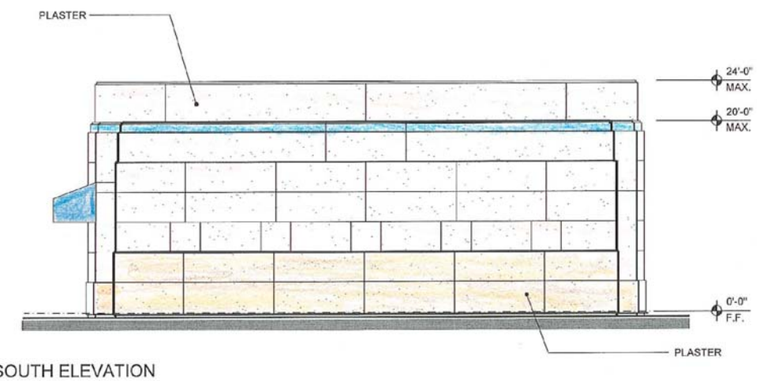

SOUTH ELEVATION

LEMOORE RETAIL

RECEIVED
PLANNING DEPT.