Redlined Site Plan

- Fencing corner to be 3' in back of sidewalk here

60' ROW exists.

- 10' PUE to be dedicated behind ROW along Acacia Dr. and Bush St.

- Enclosed fire department connections to be incorporated into bldg. design on the northerly sides of buildings close to parking lots.

- Wrought iron fence to be 3½' per City Zoning Ordinance

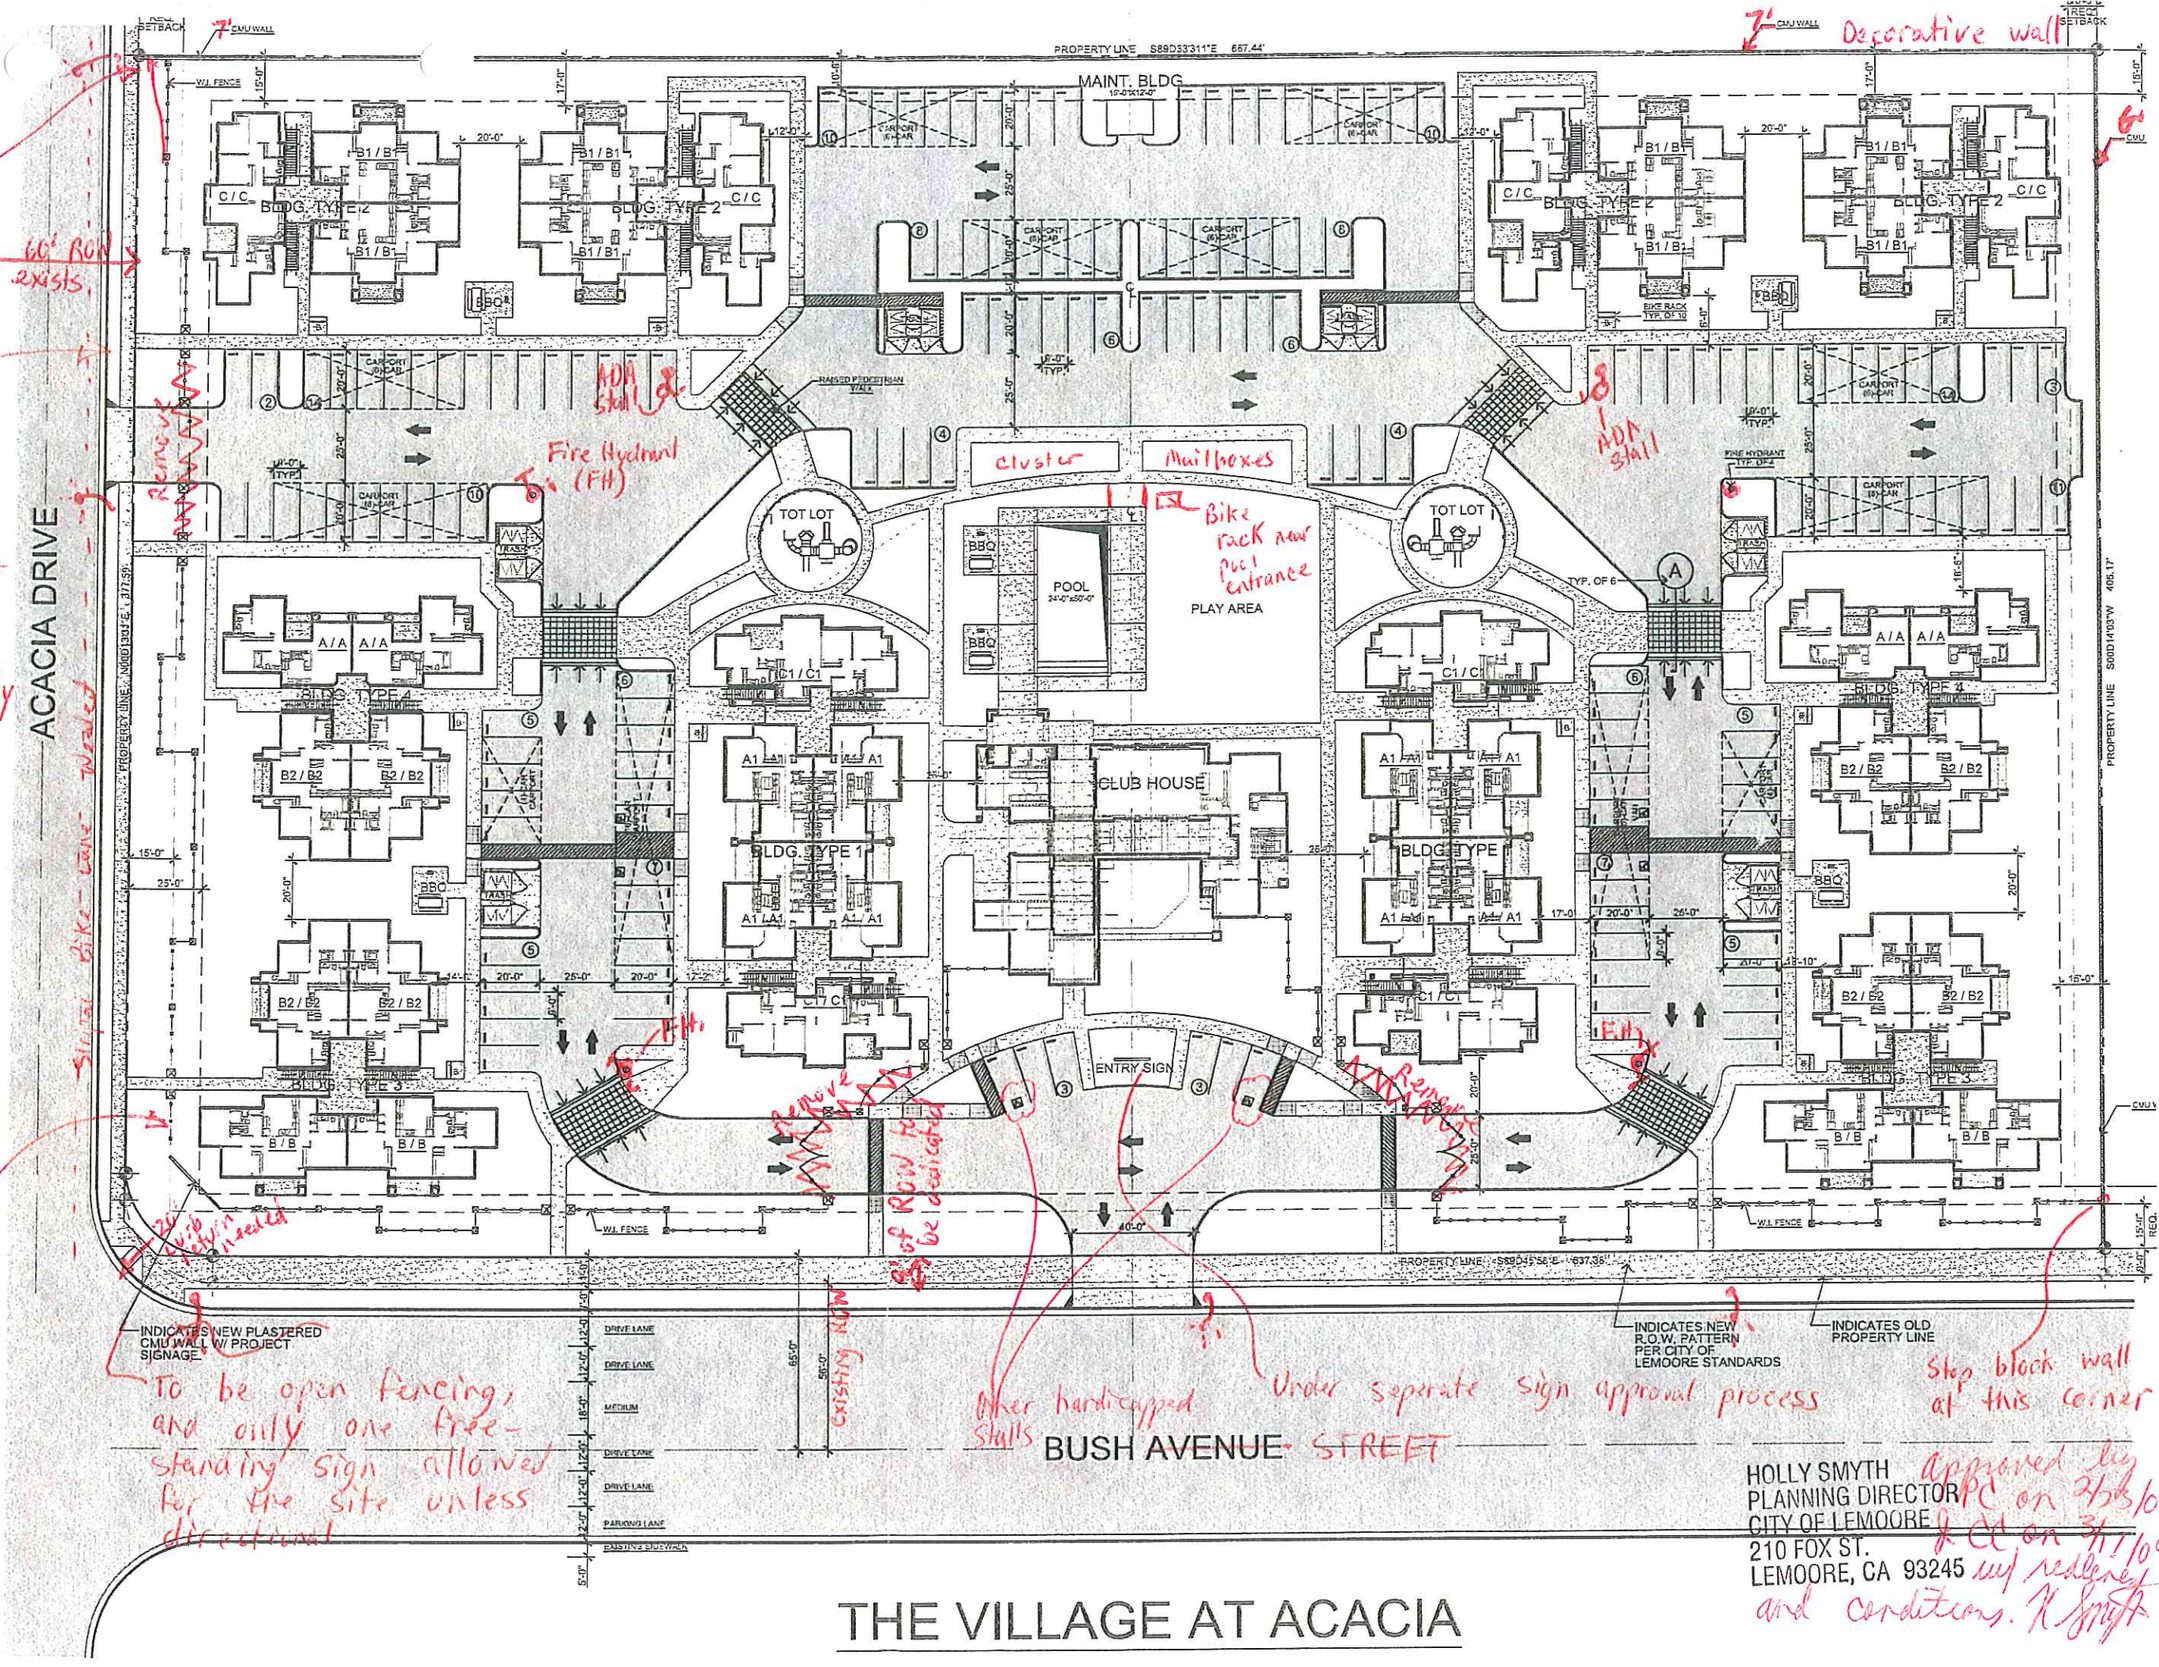

HOLLY SMYTH
PLANNING DIRECTOR
CITY OF LEMOORE
210 FOX ST.
LEMOORE, CA 93245

approved by PC on 2/25/10 & CC on 3/1/10 w/ redlined and conditions. H. Smyth

THE VILLAGE AT ACACIA

Redlined Landscape Plan

stripe bike lane

Add 2 benches to each tot lot area under trees.

Add 4 benches under arbor/mail box area for parents to watch children and socialize

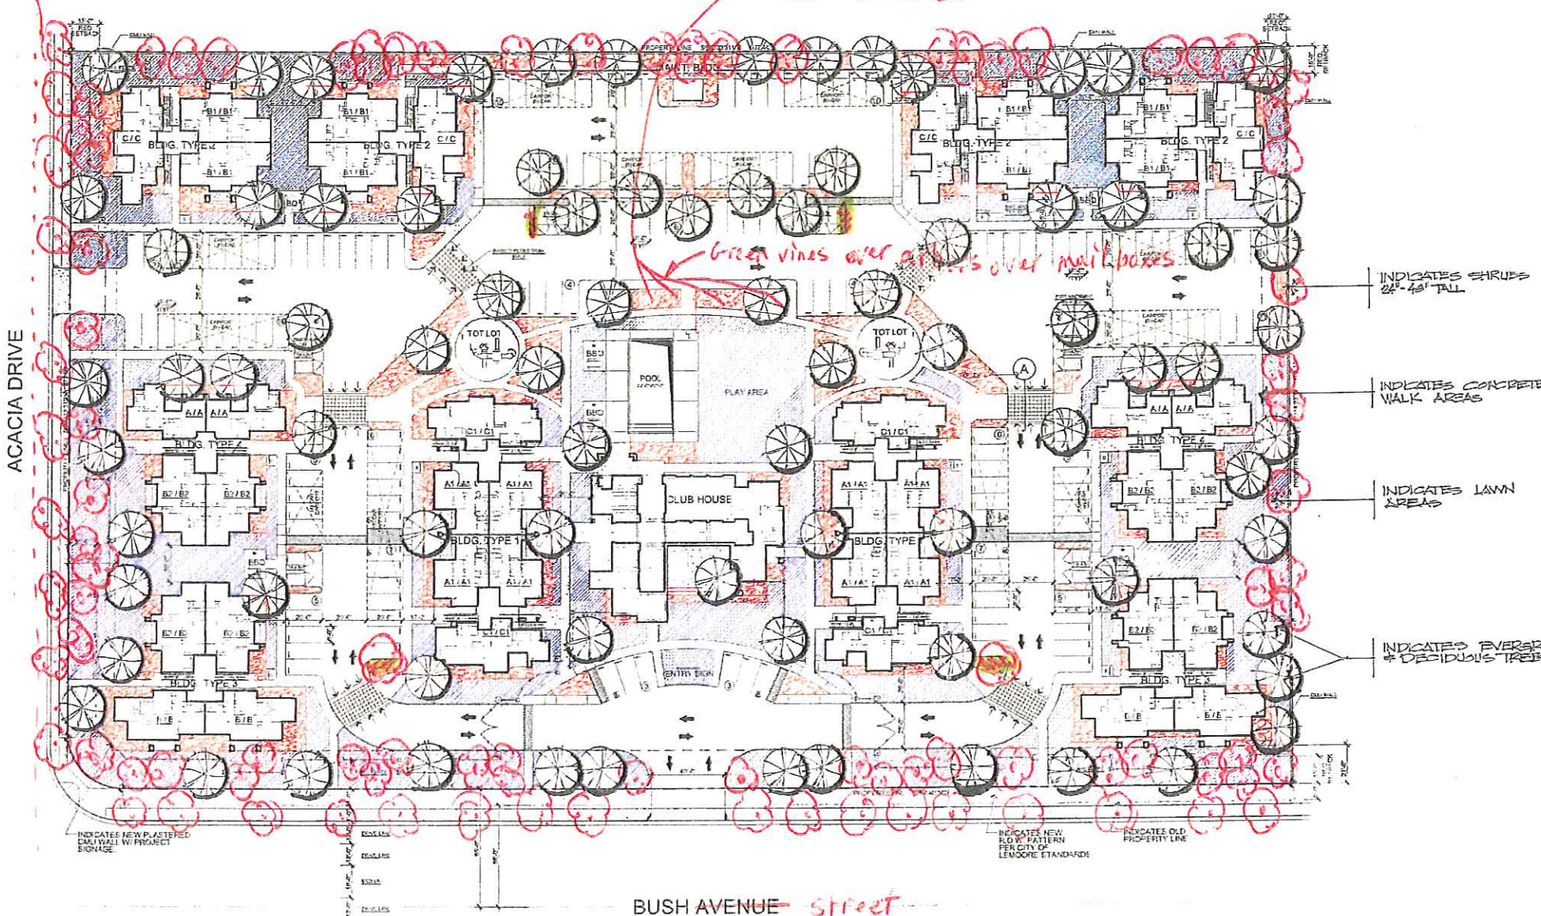

Green vines over arbors over mailboxes

INDICATES SHRUBS 24"-48" TALL

INDICATES CONCRETE WALK AREAS

INDICATES LAWN AREAS

INDICATES EVERGREEN & DECIDUOUS TREES

THE VILLAGE AT ACACIA

LEMOORE, CALIFORNIA

DEVELOPED BY:
DAVCO COMMUNITIES, LLC
&
THE PENSTAR GROUP

LANDSCAPE SITE PLAN

SCALE: 1"=30'

Approved by PC 2/3/09 & CC on 3/17/09 and conditions

HOLLY SMYTH
PLANNING DIRECTOR
CITY OF LEMOORE
210 FOX ST.
LEMOORE, CA 93245

RECEIVED
for Builders
approval
DEC 19 2008
Smyth

R.L. Davidson, Inc.
ARCHITECTURE
PLANNING
2414 W. SHAW AVE. #114
FRESNO, CA. 93711
PH. (559) 439-2370
FAX (559) 439-4410
WWW.RLDAVIDSON.COM

LICENSED ARCHITECT ROBERT L. DAVIDSON NO. C8553 EXP. 1-31-09 STATE OF CALIFORNIA

PROJECT:

THE VILLAGE AT ACACIA

LEMOORE, CALIFORNIA

FOR:
DAVCO COMMUNITIES, LLC
&
THE PENSTAR GROUP

© 2008 R.L. DAVIDSON, INC.

DATE: DECEMBER 18, 2008

SHEET NO.

P-9.0

PROJECT NO. 0633

5/08/33 Lemoore (DAVCO)\Preliminary (12-17-08)\0813 P-0.8 LANDSCAPE PLAN.dwg, 12/19/2008 10:19:49 AM, AP

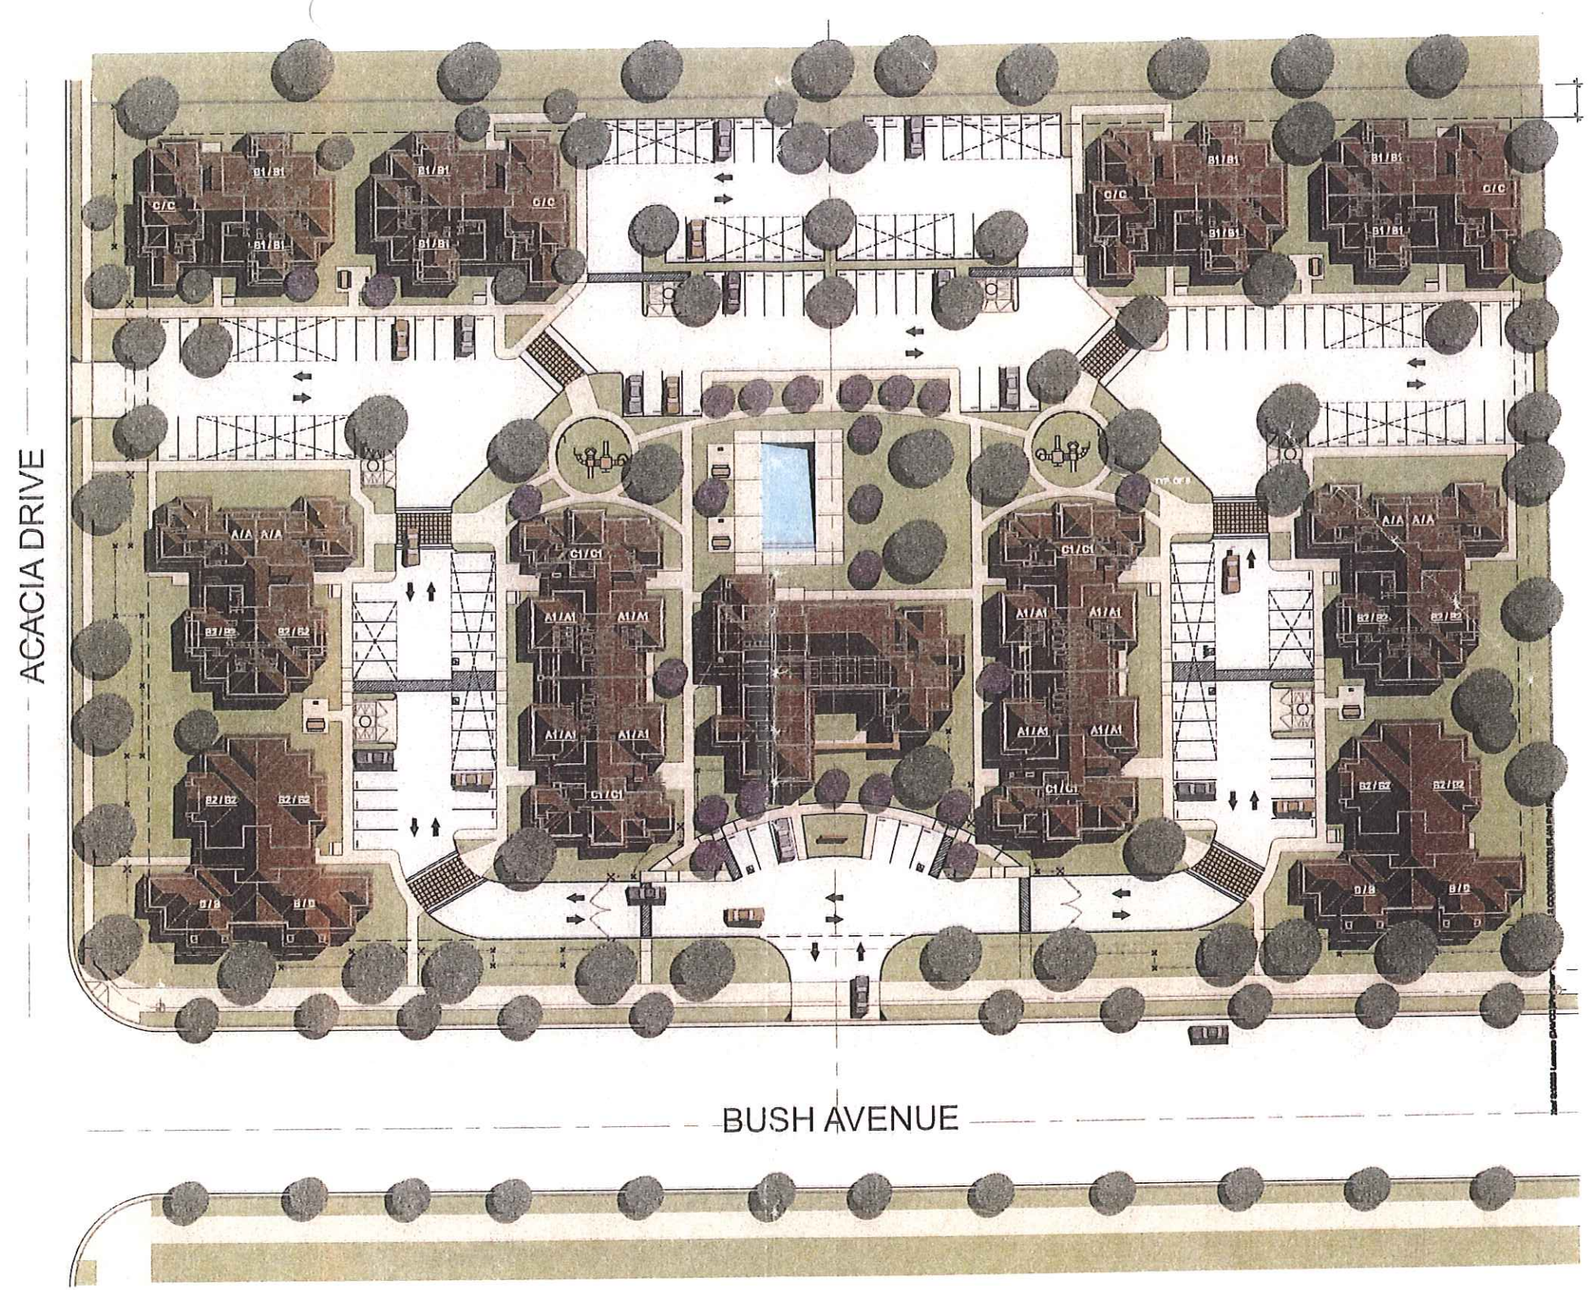

THE VILLAGE AT ACACIA

LEMOORE, CALIFORNIA

DEVELOPED BY:
DAVCO COMMUNITIES, LLC
&
THE PENSTAR GROUP
R.L. DAVIDSON, INC. ARCHITECTS

DAVCO COMMUNITIES, LLC

Approved by PC 2/23/09 & CC on 3/3/09 w/ redlines and conditions of approval
HOLLY SMYTH

HOLLY SMYTH
PLANNING DIRECTOR
CITY OF LEMOORE
210 FOX ST.
LEMOORE, CA 93245

HOLLY SMYTH
PLANNING DIRECTOR
CITY OF LEMOORE
210 FOX ST.
LEMOORE, CA 93245

Approved w/ conditions of approval by PC 12/23/09 & CC 3/17/09
H. Smyth