* Redlined & Greenlined Plans

PLAN 4A | PLAN 1CR | PLAN 3C | PLAN 2AR | PLAN 4B (BONUS)

SEE ELEVATIONS & FLOORPLANS FOR OPTIONS.

Woodside Homes
BETTER BY DESIGN

Job #: 12036
Date: Sep 13, 2012
Scale: 1/8" = 1'-0"

STREET SCENE
LEMOORE
Lemoore, CA

DRAFT

KEVIN L. CROOK ARCHITECT INC.

11-5-2012

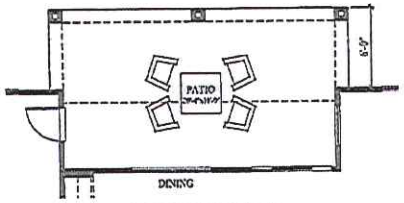

OPTIONAL PATIO

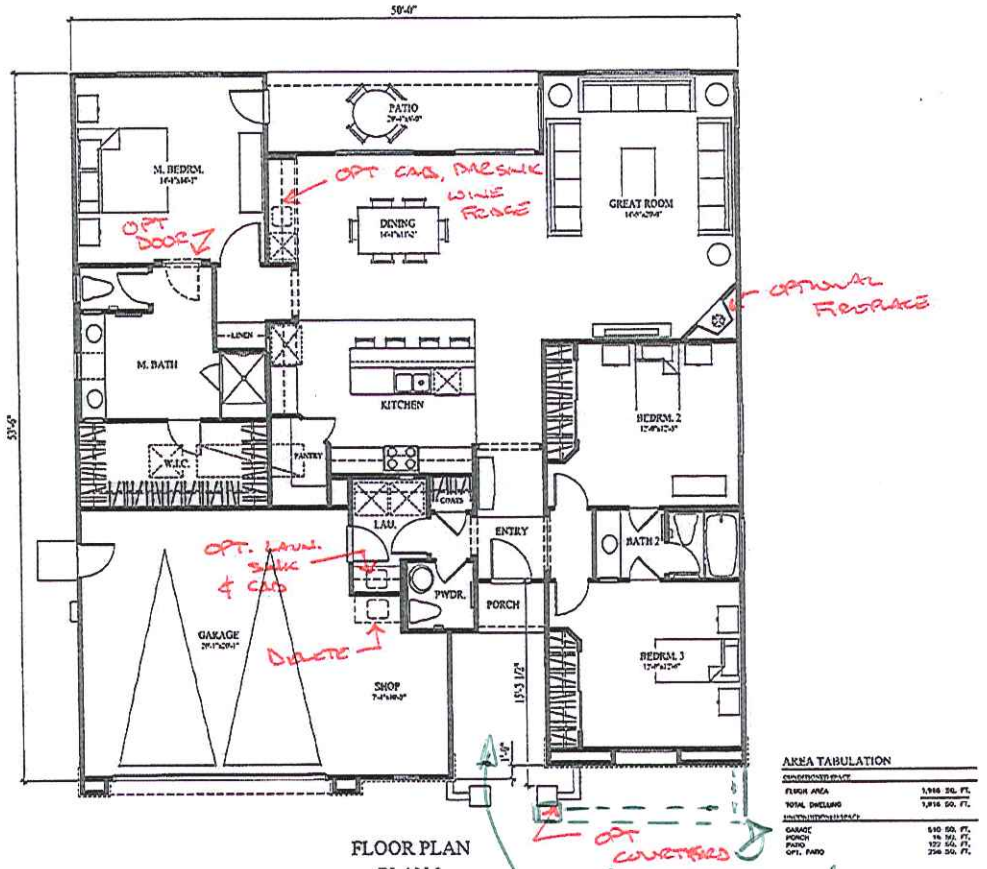

AREA TABULATION

CONDITIONED SPACE	
FLOOR AREA	1,916 SQ. FT.
TOTAL DWELLING	1,916 SQ. FT.
UNCONDITIONED SPACE	
GARAGE	510 SQ. FT.
PORCH	35 SQ. FT.
PATIO	122 SQ. FT.
OPT. PATIO	256 SQ. FT.

FLOOR PLAN
PLAN 1
LEMOORE
Lemoore, CA

DRAFT

Woodside Homes
BETTER BY DESIGN

Job #: 12036
Date: Sep 15, 2017
Scale: 1/8" = 1'-0"

KEVIN L. CROOK ARCHITECT INC.

Not useable as travel path splits area

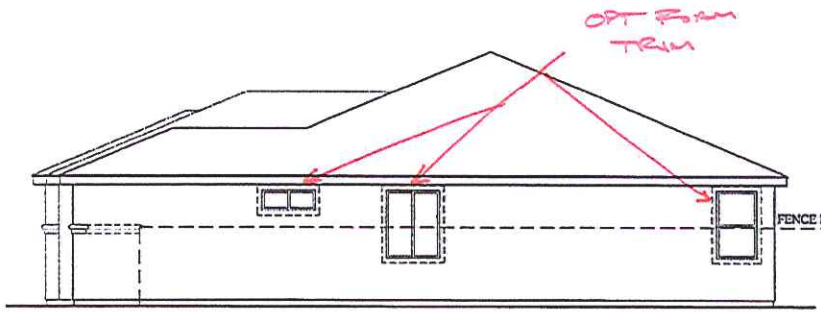

RIGHT ELEVATION

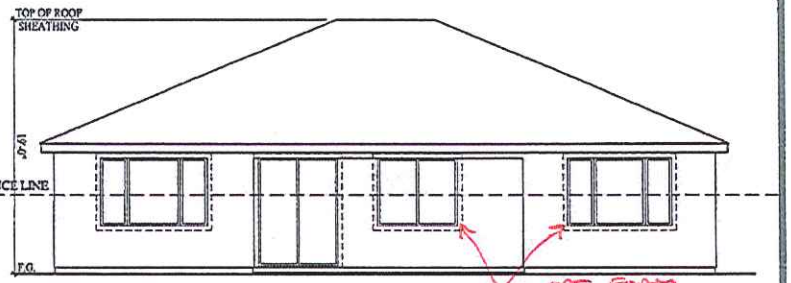

REAR ELEVATION

ITEMS SHOWN DASHED SHALL OCCUR ON LOTS ADJACENT TO PUBLIC RIGHT OF WAYS REQUIRING ENHANCEMENTS - SEE SITE PLAN

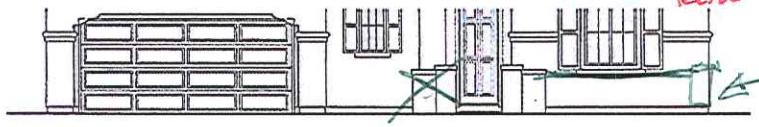

OPTIONAL COURTYARD PARTIAL FRONT ELEVATION

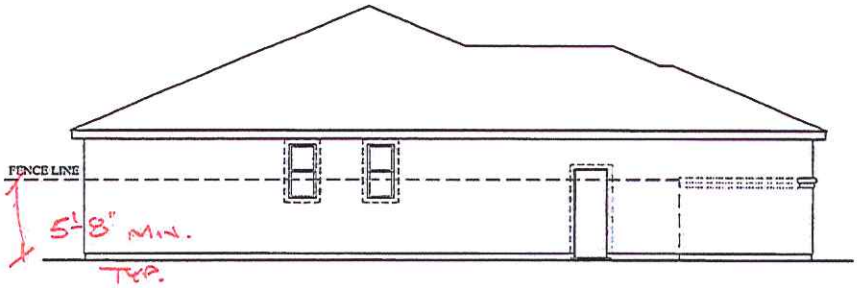

LEFT ELEVATION

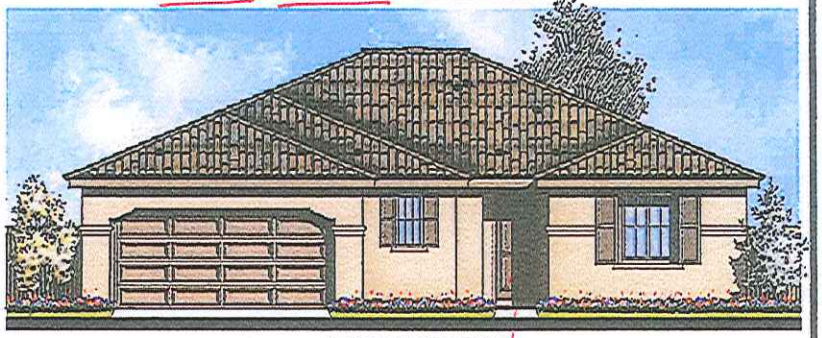

FRONT ELEVATION

ENTRY DOOR OPTIONS ??

Woodside Homes
BETTER BY DESIGN

Job #:12036
Date: Sep 18, 2012
Scale: 1/8" = 1'-0"

PLAN 1
ELEVATION "A"
LEMOORE
Lemoore, CA

DRAFT

KEVIN L. CROOK ARCHITECT INC.

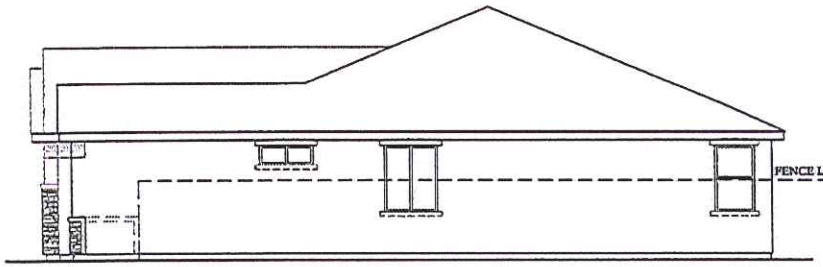

RIGHT ELEVATION

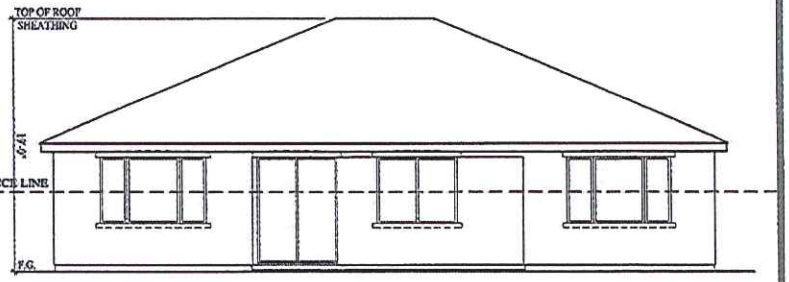

REAR ELEVATION

ITEMS SHOWN DASHED SHALL OCCUR ON LOTS ADJACENT TO PUBLIC RIGHT OF WAYS REQUIRING ENHANCEMENTS – SEE SITE PLAN

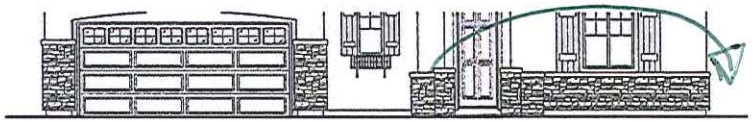

OPTIONAL COURTYARD PARTIAL FRONT ELEVATION

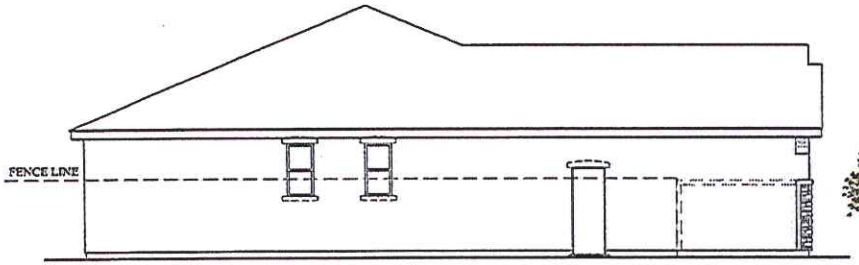

LEFT ELEVATION

FRONT ELEVATION

opt.
GAR. WINDOWS.

Woodside Homes
BETTER BY DESIGN

Job #: 12026
Date: Sep 18, 2012
Scale: 1/8" = 1'-0"

PLAN 1
ELEVATION "B"
LEMOORE
Lemoore, CA

DRAFT

KEVIN L. CROOK
ARCHITECT
INC.

© Copyright All Rights Reserved

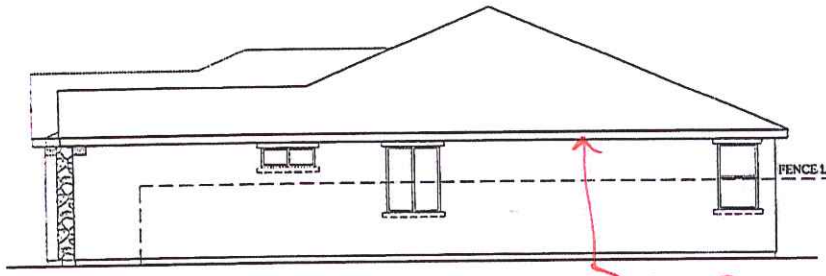

RIGHT ELEVATION

STD. FASCIA GUTTER TYP.

ITEMS SHOWN DASHED SHALL OCCUR ON LOTS ADJACENT TO PUBLIC RIGHT OF WAYS REQUIRING ENHANCEMENTS – SEE SITE PLAN

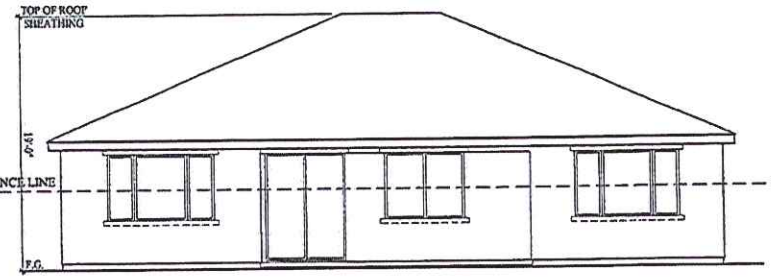

REAR ELEVATION

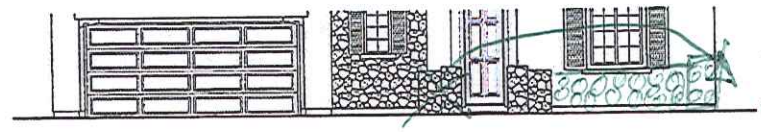

Opt. Courtyard

OPTIONAL COURTYARD PARTIAL FRONT ELEVATION

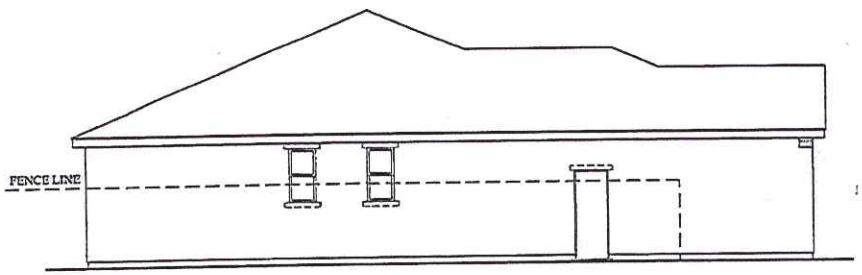

LEFT ELEVATION

FRONT ELEVATION

Woodside Homes
BETTER BY DESIGN

Job #: 12034
Date: Sep 18, 2012
Scale: 1/8" = 1'-0"

PLAN 1
ELEVATION "C"

LEMOORE

Lemoore, CA

DRAFT

KEVIN L. CROOK ARCHITECT INC.

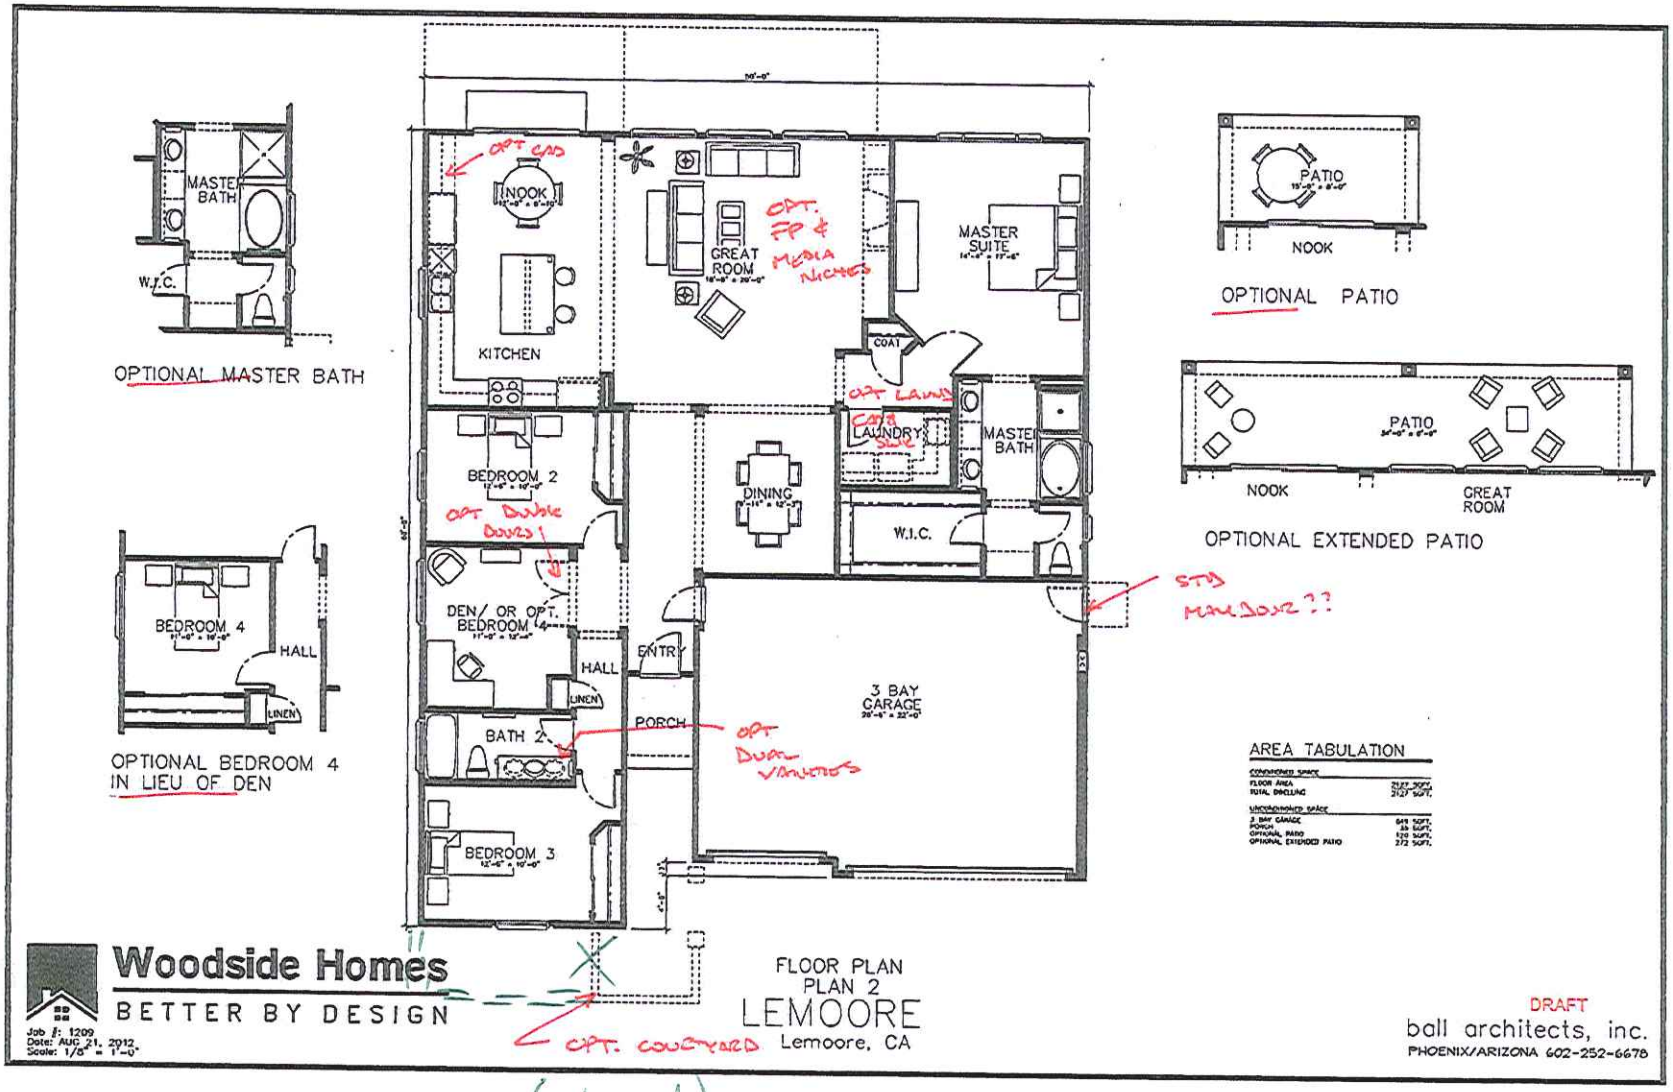
MASTER BATH
W.I.C.
OPTIONAL MASTER BATH
BEDROOM 4
HALL
LINEN
OPTIONAL BEDROOM 4 IN LIEU OF DEN
NOOK
KITCHEN
GREAT ROOM
MASTER SUITE
COAT
LAUNDRY
MASTER BATH
BEDROOM 2
DINING
W.I.C.
DEN/ OR OPT. BEDROOM 4
HALL
LINEN
ENTRY
PORCH
BATH 2
BEDROOM 3
3 BAY GARAGE
PATIO
NOOK
OPTIONAL PATIO
PATIO
NOOK
GREAT ROOM
OPTIONAL EXTENDED PATIO
AREA TABULATION
CONDITIONED SPACE
FLOOR AREA 2127 SQFT.
TOTAL DWELLING 2127 SQFT.
UNCONDITIONED SPACE
3 BAY GARAGE 649 SQFT.
PORCH 36 SQFT.
OPTIONAL PATIO 120 SQFT.
OPTIONAL EXTENDED PATIO 272 SQFT.
Woodside Homes
BETTER BY DESIGN
Job #: 1209
Date: AUG 21, 2012
Scale: 1/8" = 1'-0"
FLOOR PLAN
PLAN 2
LEMOORE
Lemoore, CA
DRAFT
ball architects, inc.
PHOENIX/ARIZONA 602-252-6678

(enlarged)

RIGHT ELEVATION

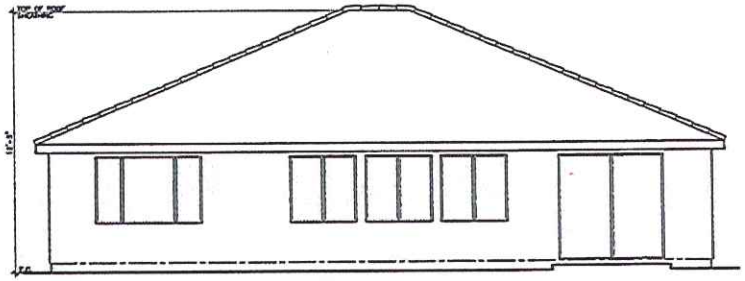

REAR ELEVATION

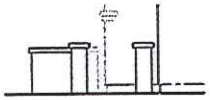

OPTIONAL COURTYARD PARTIAL RIGHT ELEVATION

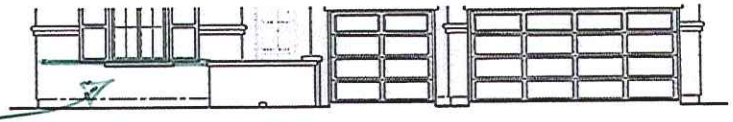

OPTIONAL COURTYARD PARTIAL FRONT ELEVATION

opt. expanded courtyard

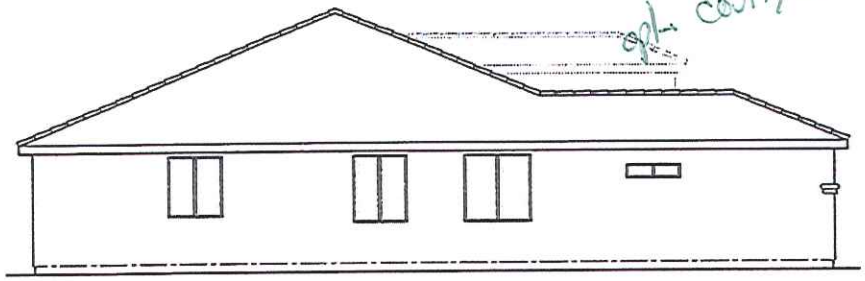

LEFT ELEVATION

FRONT ELEVATION

Woodside Homes
BETTER BY DESIGN

Job #: 1209
Date: AUG 21, 2012
Scale: 1/8" = 1'-0"

ELEVATION "A"
PLAN 2
LEMOORE
Lemoore, CA

DRAFT
ball architects, inc.
PHOENIX/ARIZONA 602-252-6678

RIGHT ELEVATION

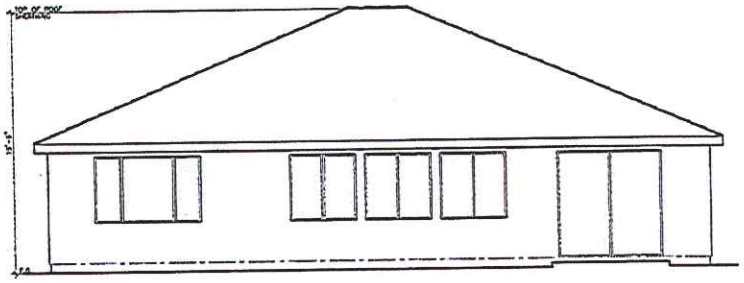

REAR ELEVATION

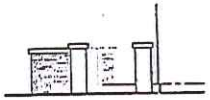

OPTIONAL COURTYARD PARTIAL RIGHT ELEVATION

expanded opt. courtyard

OPTIONAL COURTYARD PARTIAL FRONT ELEVATION

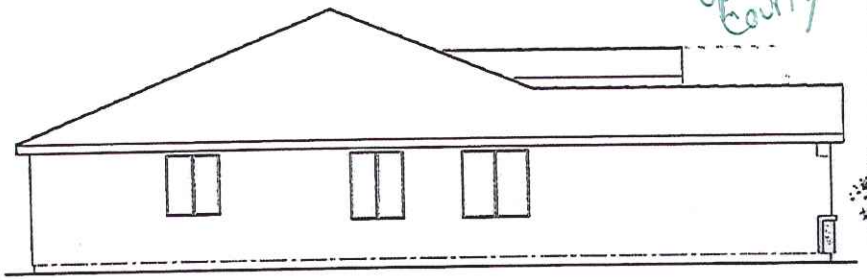

LEFT ELEVATION

FRONT ELEVATION

opt. gar windows

Woodside Homes

BETTER BY DESIGN

Job #: 1209
Date: AUG 21, 2012
Scale: 1/8" = 1'-0"

ELEVATION "B"
PLAN 2

LEMOORE

Lemoore, CA

DRAFT

ball architects, inc.

PHOENIX/ARIZONA 602-252-6678

RIGHT ELEVATION

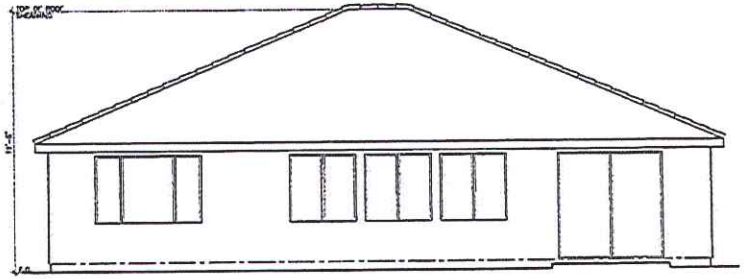

REAR ELEVATION

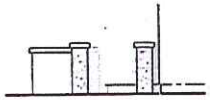

OPTIONAL COURTYARD PARTIAL RIGHT ELEVATION

expanded opt. courtyard

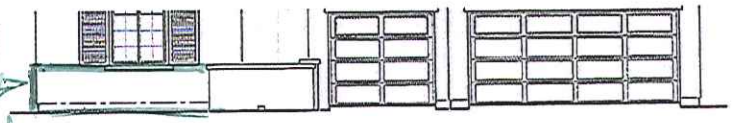

OPTIONAL COURTYARD PARTIAL FRONT ELEVATION

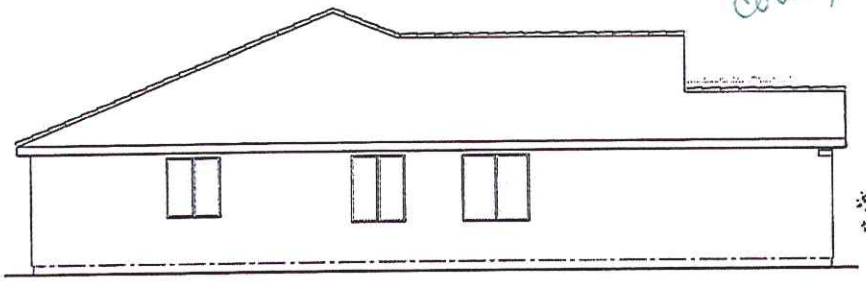

LEFT ELEVATION

FRONT ELEVATION

Woodside Homes

BETTER BY DESIGN

Job #: 1209
Date: AUG 21, 2012
Scale: 1/8" = 1'-0"

ELEVATION "C"
PLAN 2

LEMOORE

Lemoore, CA

DRAFT

ball architects, inc.

PHOENIX/ARIZONA 602-252-6678

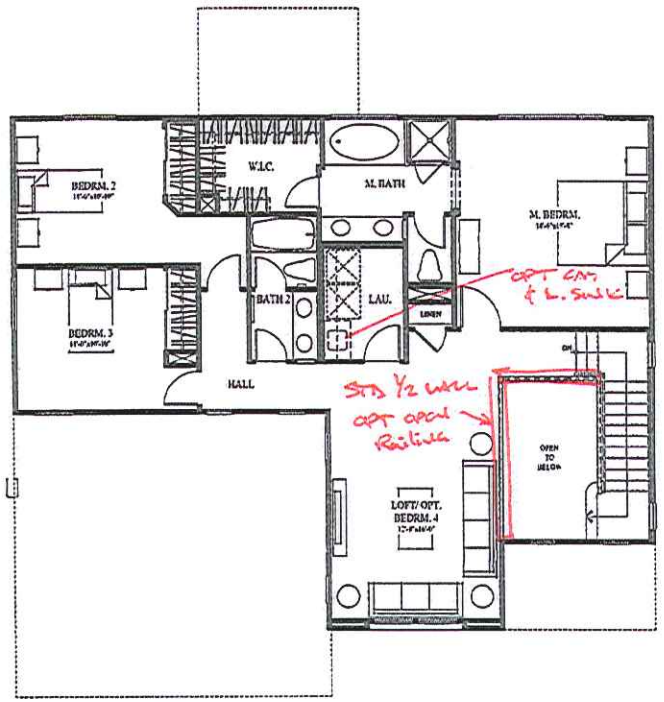

SECOND FLOOR PLAN

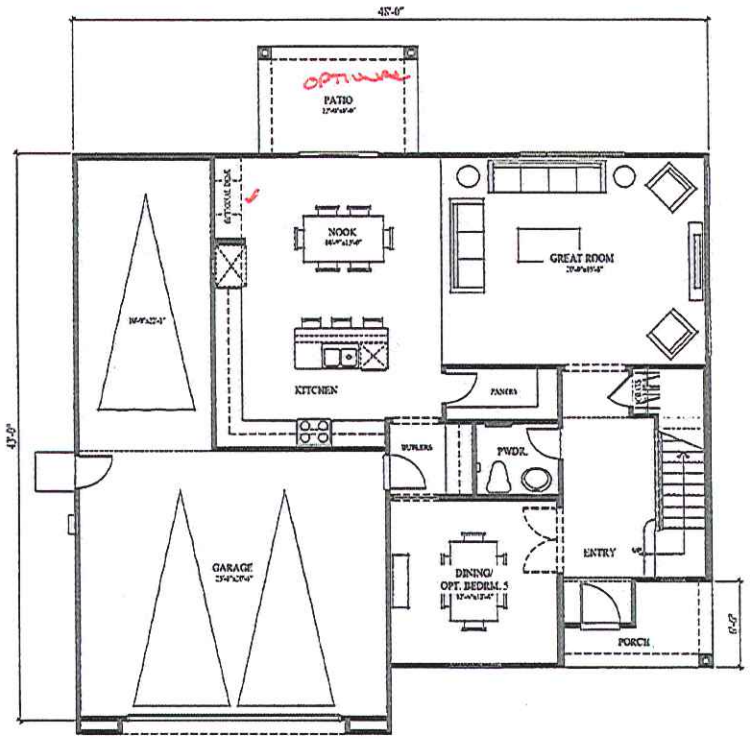

FIRST FLOOR PLAN

AREA TABULATION

CONDITIONED SPACE	
FIRST FLOOR AREA	1,200 SQ. FT.
SECOND FLOOR AREA	1,231 SQ. FT.
TOTAL DWELLING	2,431 SQ. FT.
UNCONDITIONED SPACE	
GARAGE	711 SQ. FT.
PORCH	54 SQ. FT.
PATIO	96 SQ. FT.
OPTIONAL PATIO	96 SQ. FT.

PLAN 3

LEMOORE

Lemoore, CA

Woodside Homes

BETTER BY DESIGN

Job #: 12036
Date: Sep 10, 2012
Scale: 1/8" = 1'-0"

DRAFT

KEVIN L. CROOK ARCHITECT INC.

© Copyright. All Rights Reserved

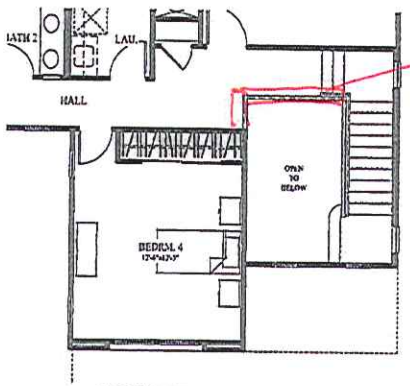

STD 1/2 WALL
OPT. OPEN RAIL

OPTIONAL BEDROOM 4

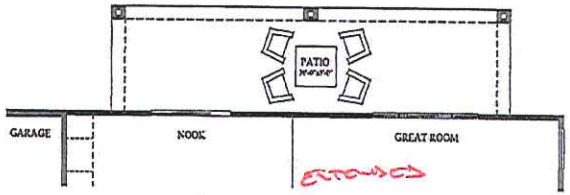

EXTENDED

OPTIONAL PATIO

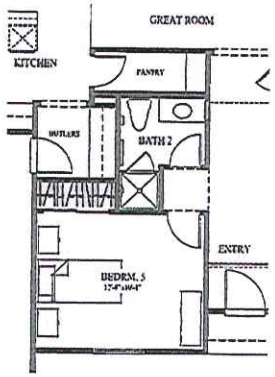

OPTIONAL BEDROOM 5

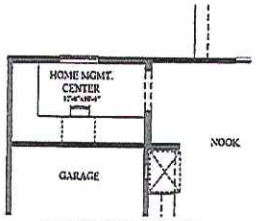

OPTIONAL HOME MANAGEMENT CENTER

Woodside Homes
BETTER BY DESIGN

Job #: 12036
Date: Sep 10, 2012
Scale: 1/8" = 1'-0"

FLOOR PLAN OPTIONS
PLAN 3
LEMOORE
Lemoore, CA

DRAFT
KEVIN L. CROOK ARCHITECT INC.

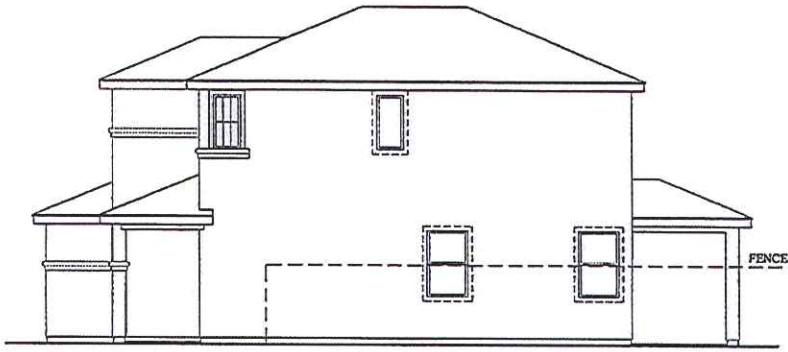

RIGHT ELEVATION

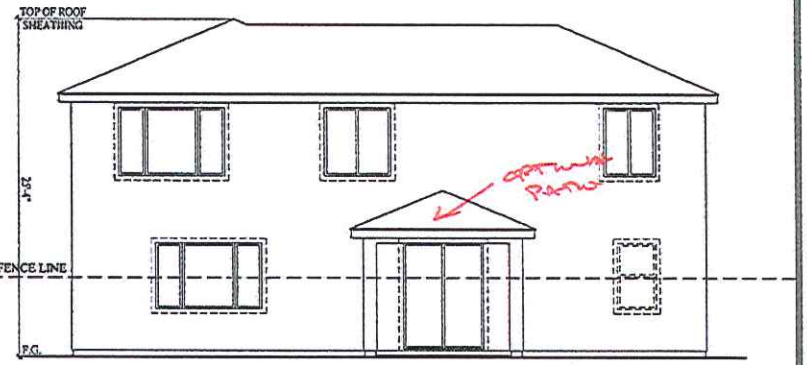

REAR ELEVATION

ITEMS SHOWN DASHED SHALL OCCUR ON LOTS ADJACENT TO PUBLIC RIGHT OF WAYS REQUIRING ENHANCEMENTS – SEE SITE PLAN

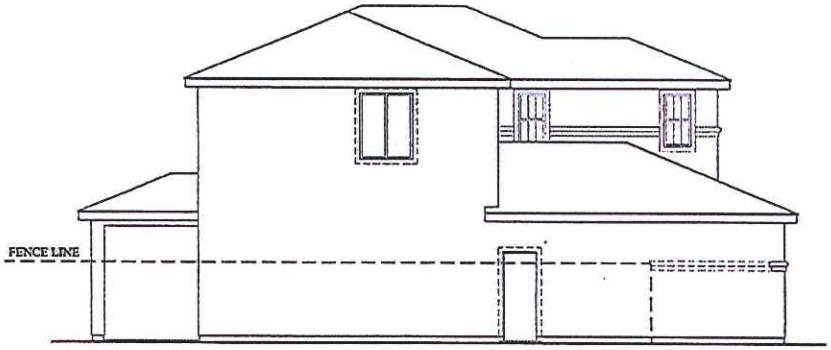

LEFT ELEVATION

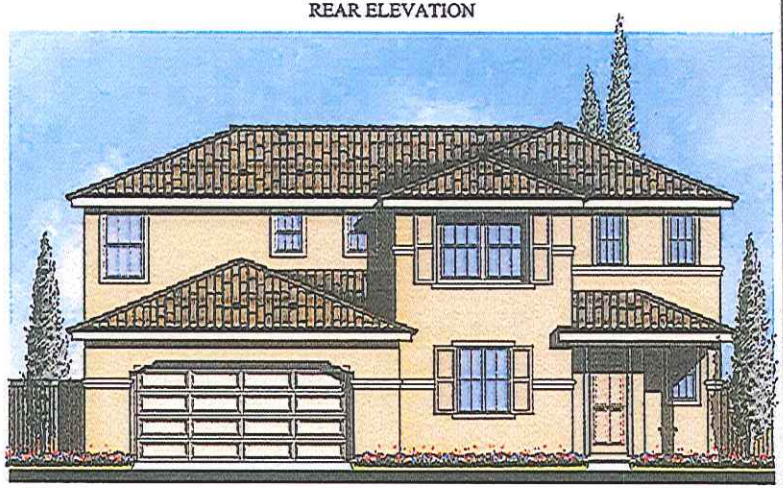

FRONT ELEVATION

Woodside Homes
BETTER BY DESIGN

Job #:12036
Date: Sep 15, 2012
Scale: 1/8" = 1'-0"

PLAN 3
ELEVATION "A"
LEMOORE
Lemoore, CA

DRAFT
KEVIN L. CROOK
ARCHITECT
INC.

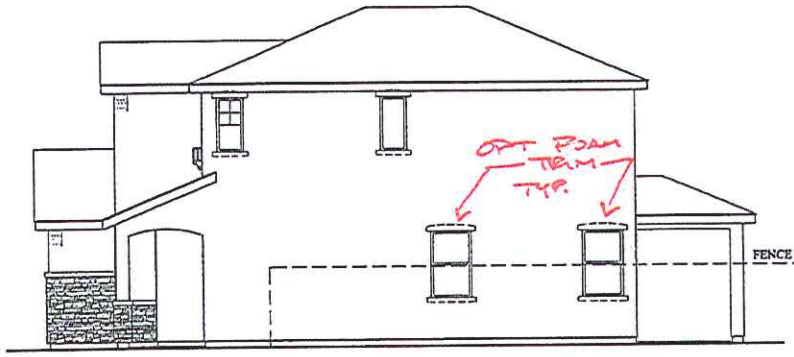

RIGHT ELEVATION

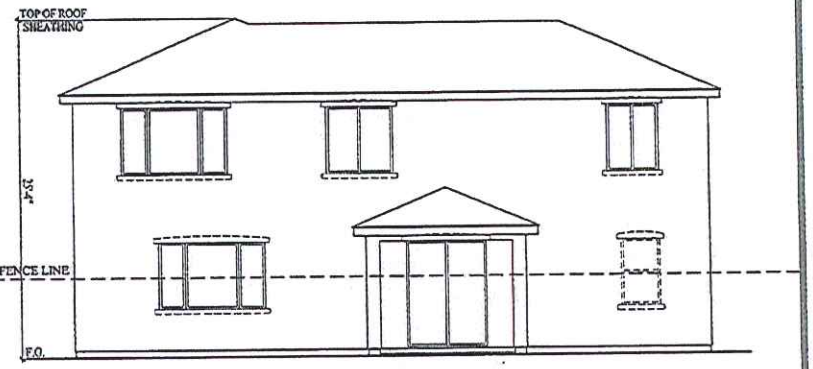

REAR ELEVATION

ITEMS SHOWN DASHED SHALL OCCUR ON LOTS ADJACENT TO PUBLIC RIGHT OF WAYS REQUIRING ENHANCEMENTS – SEE SITE PLAN

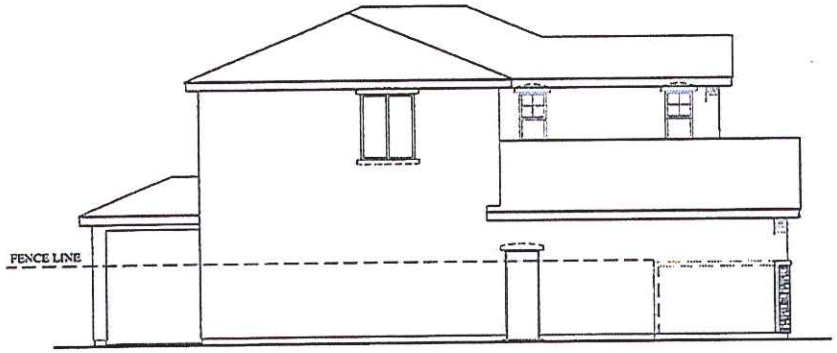

LEFT ELEVATION

FRONT ELEVATION

OPT. ARCH. WINDOWS

PLAN 3
ELEVATION "B"

LEMOORE

Lemoore, CA

Woodside Homes
BETTER BY DESIGN

Job #: 12036
Date: Sep 18, 2012
Scale: 1/8" = 1'-0"

DRAFT
KEVIN L. CROOK ARCHITECT INC.

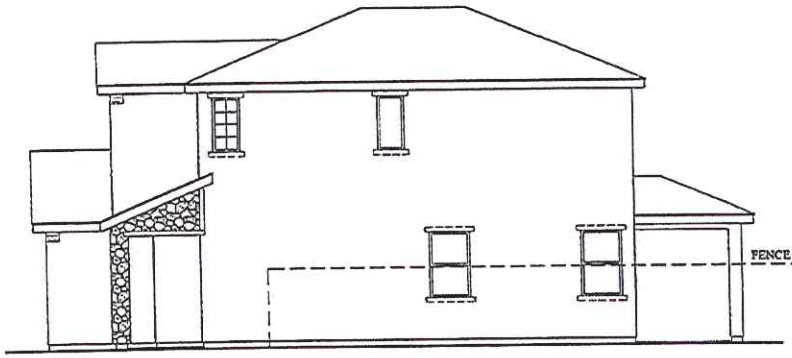

RIGHT ELEVATION

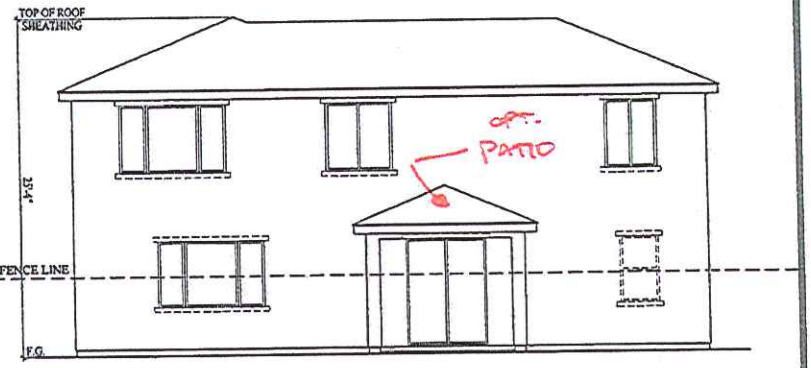

REAR ELEVATION

ITEMS SHOWN DASHED SHALL OCCUR ON LOTS ADJACENT TO PUBLIC RIGHT OF WAYS REQUIRING ENHANCEMENTS – SEE SITE PLAN

LEFT ELEVATION

FRONT ELEVATION

Woodside Homes
BETTER BY DESIGN

Job #:12036
Date: Sep 7th, 2012
Scale: 1/8" = 1'-0"

PLAN 3
ELEVATION "C"

LEMOORE

Lemoore, CA

DRAFT
KEVIN L. CROOK ARCHITECT INC.

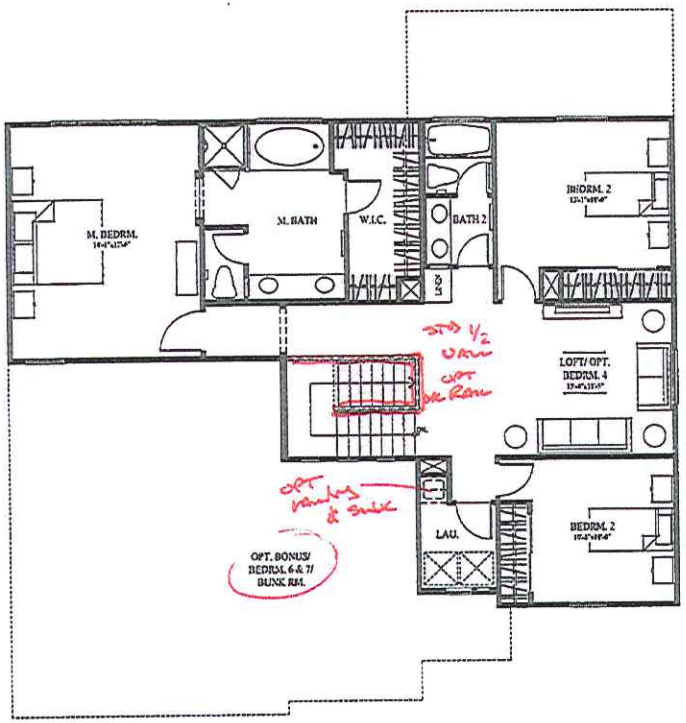

SECOND FLOOR PLAN

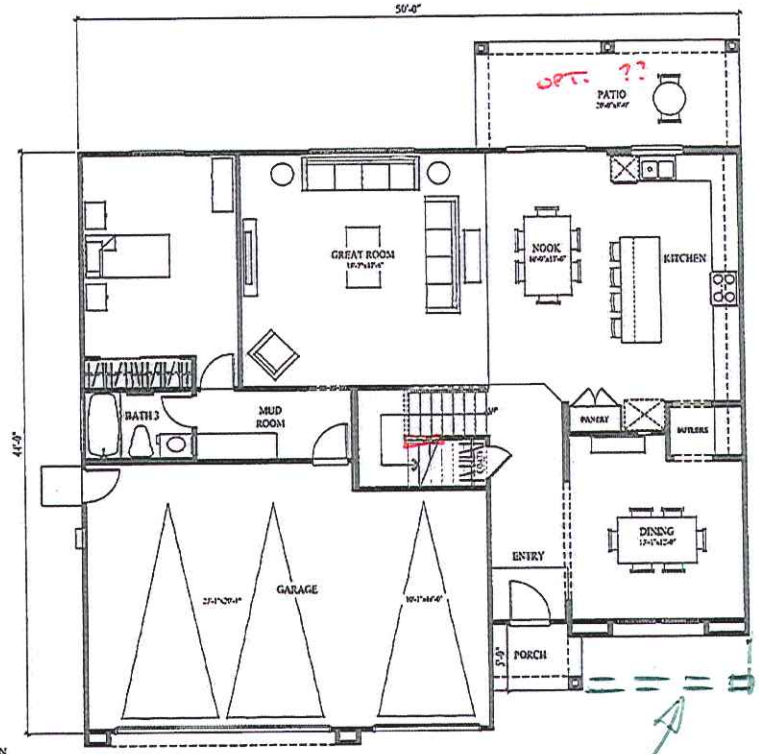

FIRST FLOOR PLAN

Optional patio shown on elevation

AREA TABULATION

CONDITIONED SPACE	
FIRST FLOOR AREA	1,444 SQ. FT.
SECOND FLOOR AREA	1,270 SQ. FT.
TOTAL DWELLING	2,714 SQ. FT.
OPT. BONUS/ BUNK RM./ BEDRM. 6 & BEDRM. 7 SECOND FLOOR AREA	1,703 SQ. FT.
TOTAL DWELLING	3,147 SQ. FT.
UNCONDITIONED SPACE	
GARAGE	601 SQ. FT.
PORCH	32 SQ. FT.
PATIO	160 SQ. FT.
OPT. PATIO	358 SQ. FT.

PLAN 4

LEMOORE

Lemoore, CA

Woodside Homes

BETTER BY DESIGN

Job #: 12036
Date: Sep 13, 2012
Scale: 1/8" = 1'-0"

DRAFT

KEVIN L. CROOK ARCHITECT INC.

© Copyright - All Rights Reserved

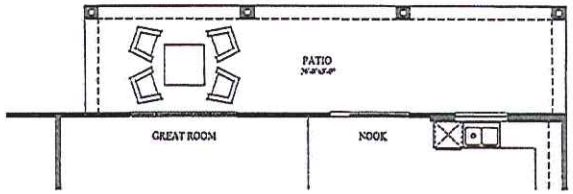

OPTIONAL PATIO

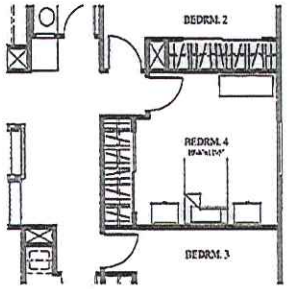

OPTIONAL BEDROOM 4

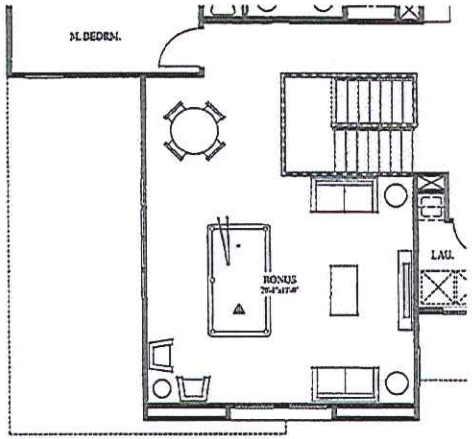

OPTIONAL BONUS

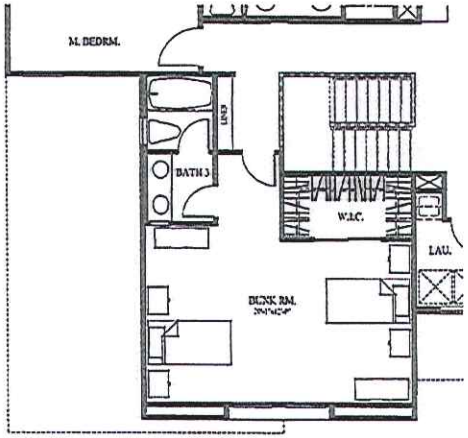

OPTIONAL BUNK ROOM

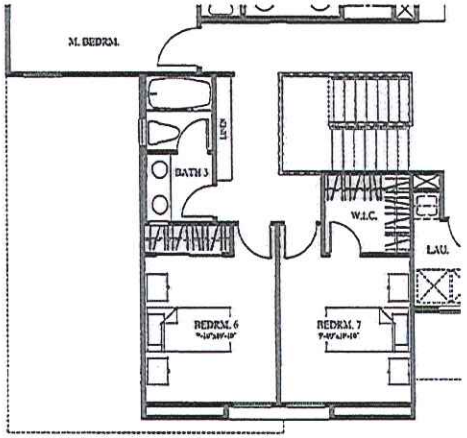

OPTIONAL BEDROOM 6 & 7

FLOOR PLAN OPTIONS

PLAN 4

LEMOORE

Lemoore, CA

Woodside Homes

BETTER BY DESIGN

Job #: 12036
Date: Sep 18, 2012
Scale: 1/8" = 1'-0"

DRAFT

KEVIN L. CROOK ARCHITECT INC.

© Copyright. All Rights Reserved

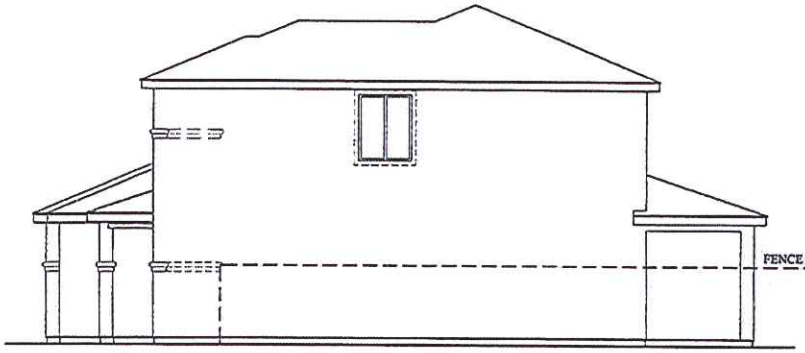

RIGHT ELEVATION

REAR ELEVATION

ITEMS SHOWN DASHED SHALL OCCUR ON LOTS ADJACENT TO PUBLIC RIGHT OF WAYS REQUIRING ENHANCEMENTS – SEE SITE PLAN

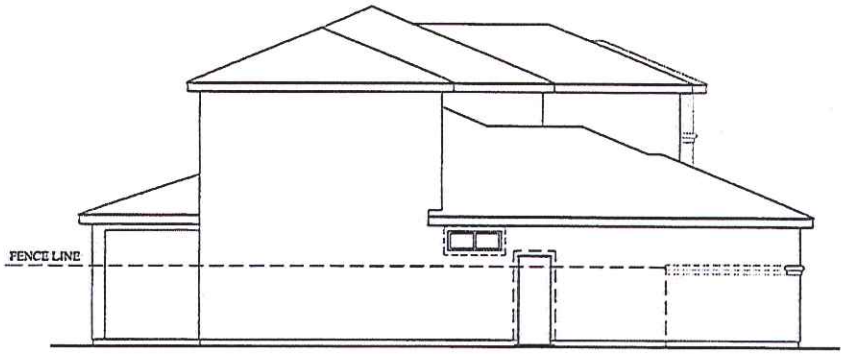

LEFT ELEVATION

FRONT ELEVATION

Woodside Homes
BETTER BY DESIGN

Job #:12036
Date: Sep 18, 2012
Scale: 1/8" = 1'-0"

PLAN 4
ELEVATION "A"
LEMOORE
Lemoore, CA

DRAFT
KEVIN L. CROOK ARCHITECT INC.

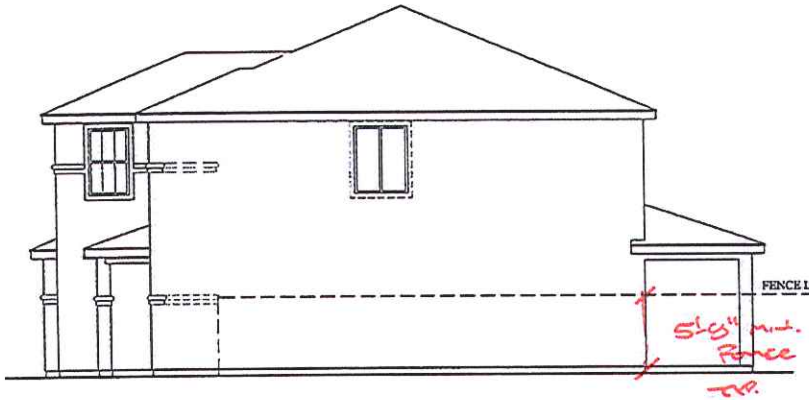

RIGHT ELEVATION

REAR ELEVATION

LEFT ELEVATION

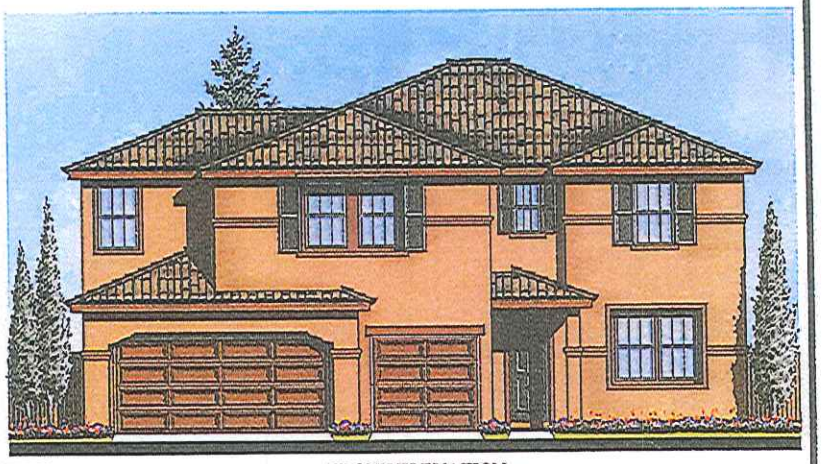

FRONT ELEVATION

OPTIONAL BONUS
PLAN 4
ELEVATION "A"

LEMOORE

Lemoore, CA

Woodside Homes
BETTER BY DESIGN

Job #: 12036
Date: Sep 18, 2012
Scale: 1/8" = 1'-0"

DRAFT

KEVIN L. CROOK
ARCHITECT
INC.

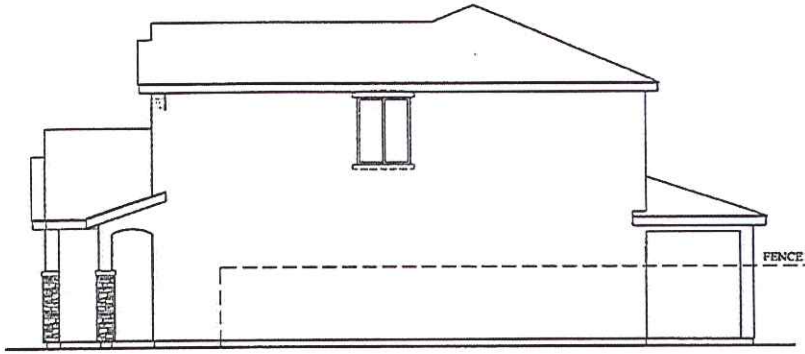

RIGHT ELEVATION

REAR ELEVATION

ITEMS SHOWN DASHED SHALL OCCUR ON LOTS ADJACENT TO PUBLIC RIGHT OF WAYS REQUIRING ENHANCEMENTS – SEE SITE PLAN

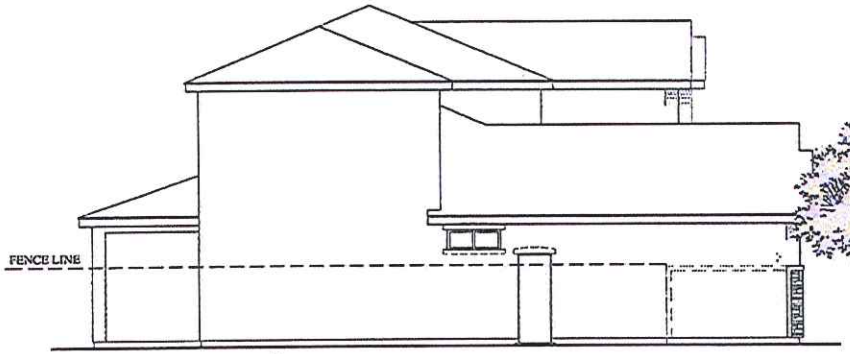

LEFT ELEVATION

FRONT ELEVATION

OPT. GAR WINDOWS

PLAN 4
ELEVATION "B"

LEMOORE

Lemoore, CA

Woodside Homes
BETTER BY DESIGN

Job #: 12036
Date: Sep 18, 2012
Scale: 1/8" = 1'-0"

DRAFT
KEVIN L. CROOK ARCHITECT INC.

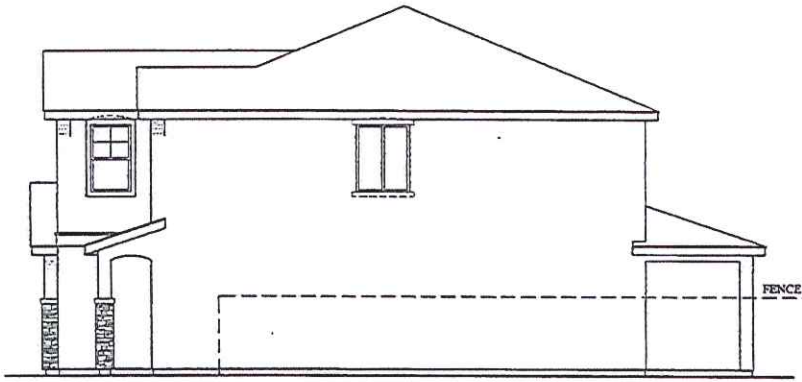

RIGHT ELEVATION

REAR ELEVATION

LEFT ELEVATION

FRONT ELEVATION

DO WE NEED TO REVISE TO MATCH CURRENT FENCE DETAIL?

OPT GARAGE WINDOWS

OPTIONAL BONUS
PLAN 4
ELEVATION "B"

LEMOORE

Lemoore, CA

Woodside Homes
BETTER BY DESIGN

Job #:120036
Date: Sep 18, 2012
Scale: 1/8" = 1'-0"

DRAFT

KEVIN L. CROOK
ARCHITECT
INC.

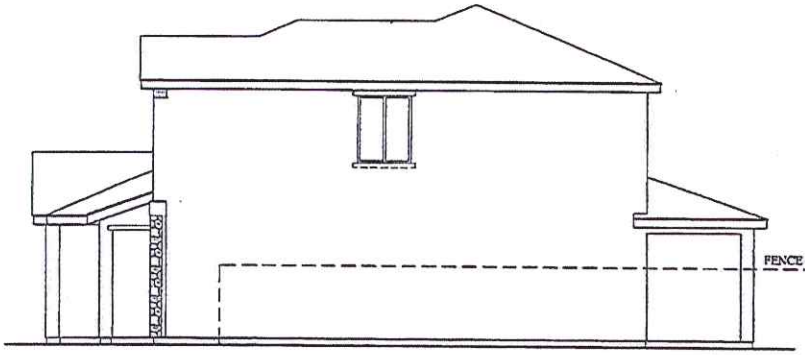

RIGHT ELEVATION

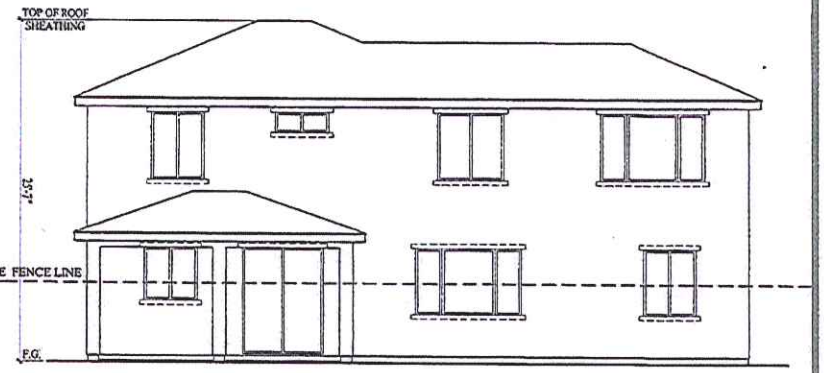

REAR ELEVATION

ITEMS SHOWN DASHED SHALL OCCUR ON LOTS ADJACENT TO PUBLIC RIGHT OF WAYS REQUIRING ENHANCEMENTS – SEE SITE PLAN

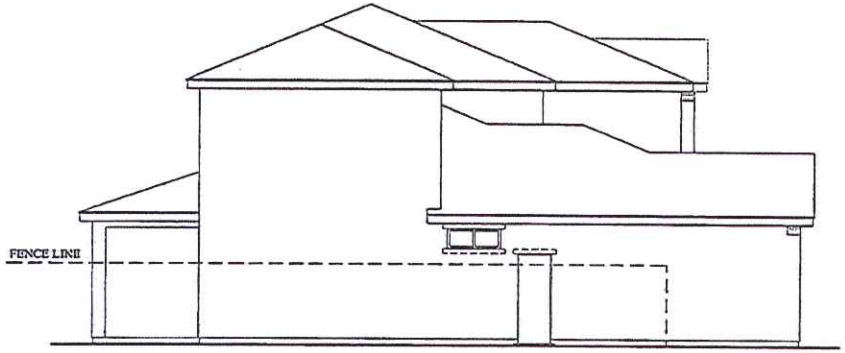

LEFT ELEVATION

FRONT ELEVATION

Woodside Homes
BETTER BY DESIGN

Job #:12036
Date: Sep 18, 2012
Scale: 1/8" = 1'-0"

PLAN 4
ELEVATION "C"
LEMOORE
Lemoore, CA

DRAFT
KEVIN L. CROOK
ARCHITECT
INC.

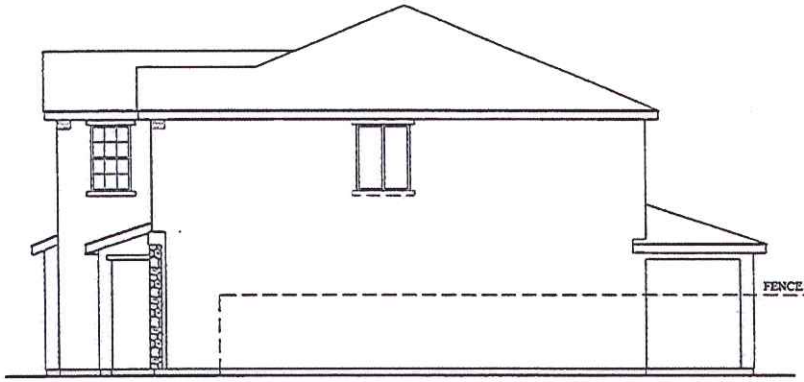

RIGHT ELEVATION

REAR ELEVATION

LEFT ELEVATION

FRONT ELEVATION

OPTIONAL BONUS
PLAN 4
ELEVATION "C"

LEMOORE

Lemoore, CA

Woodside Homes
BETTER BY DESIGN

Job #: 12038
Date: Sep 19, 2012
Scale: 1/8" = 1'-0"

DRAFT
KEVIN L. CROOK
ARCHITECT
INC.