Farmers Fury Submitted Site Plan

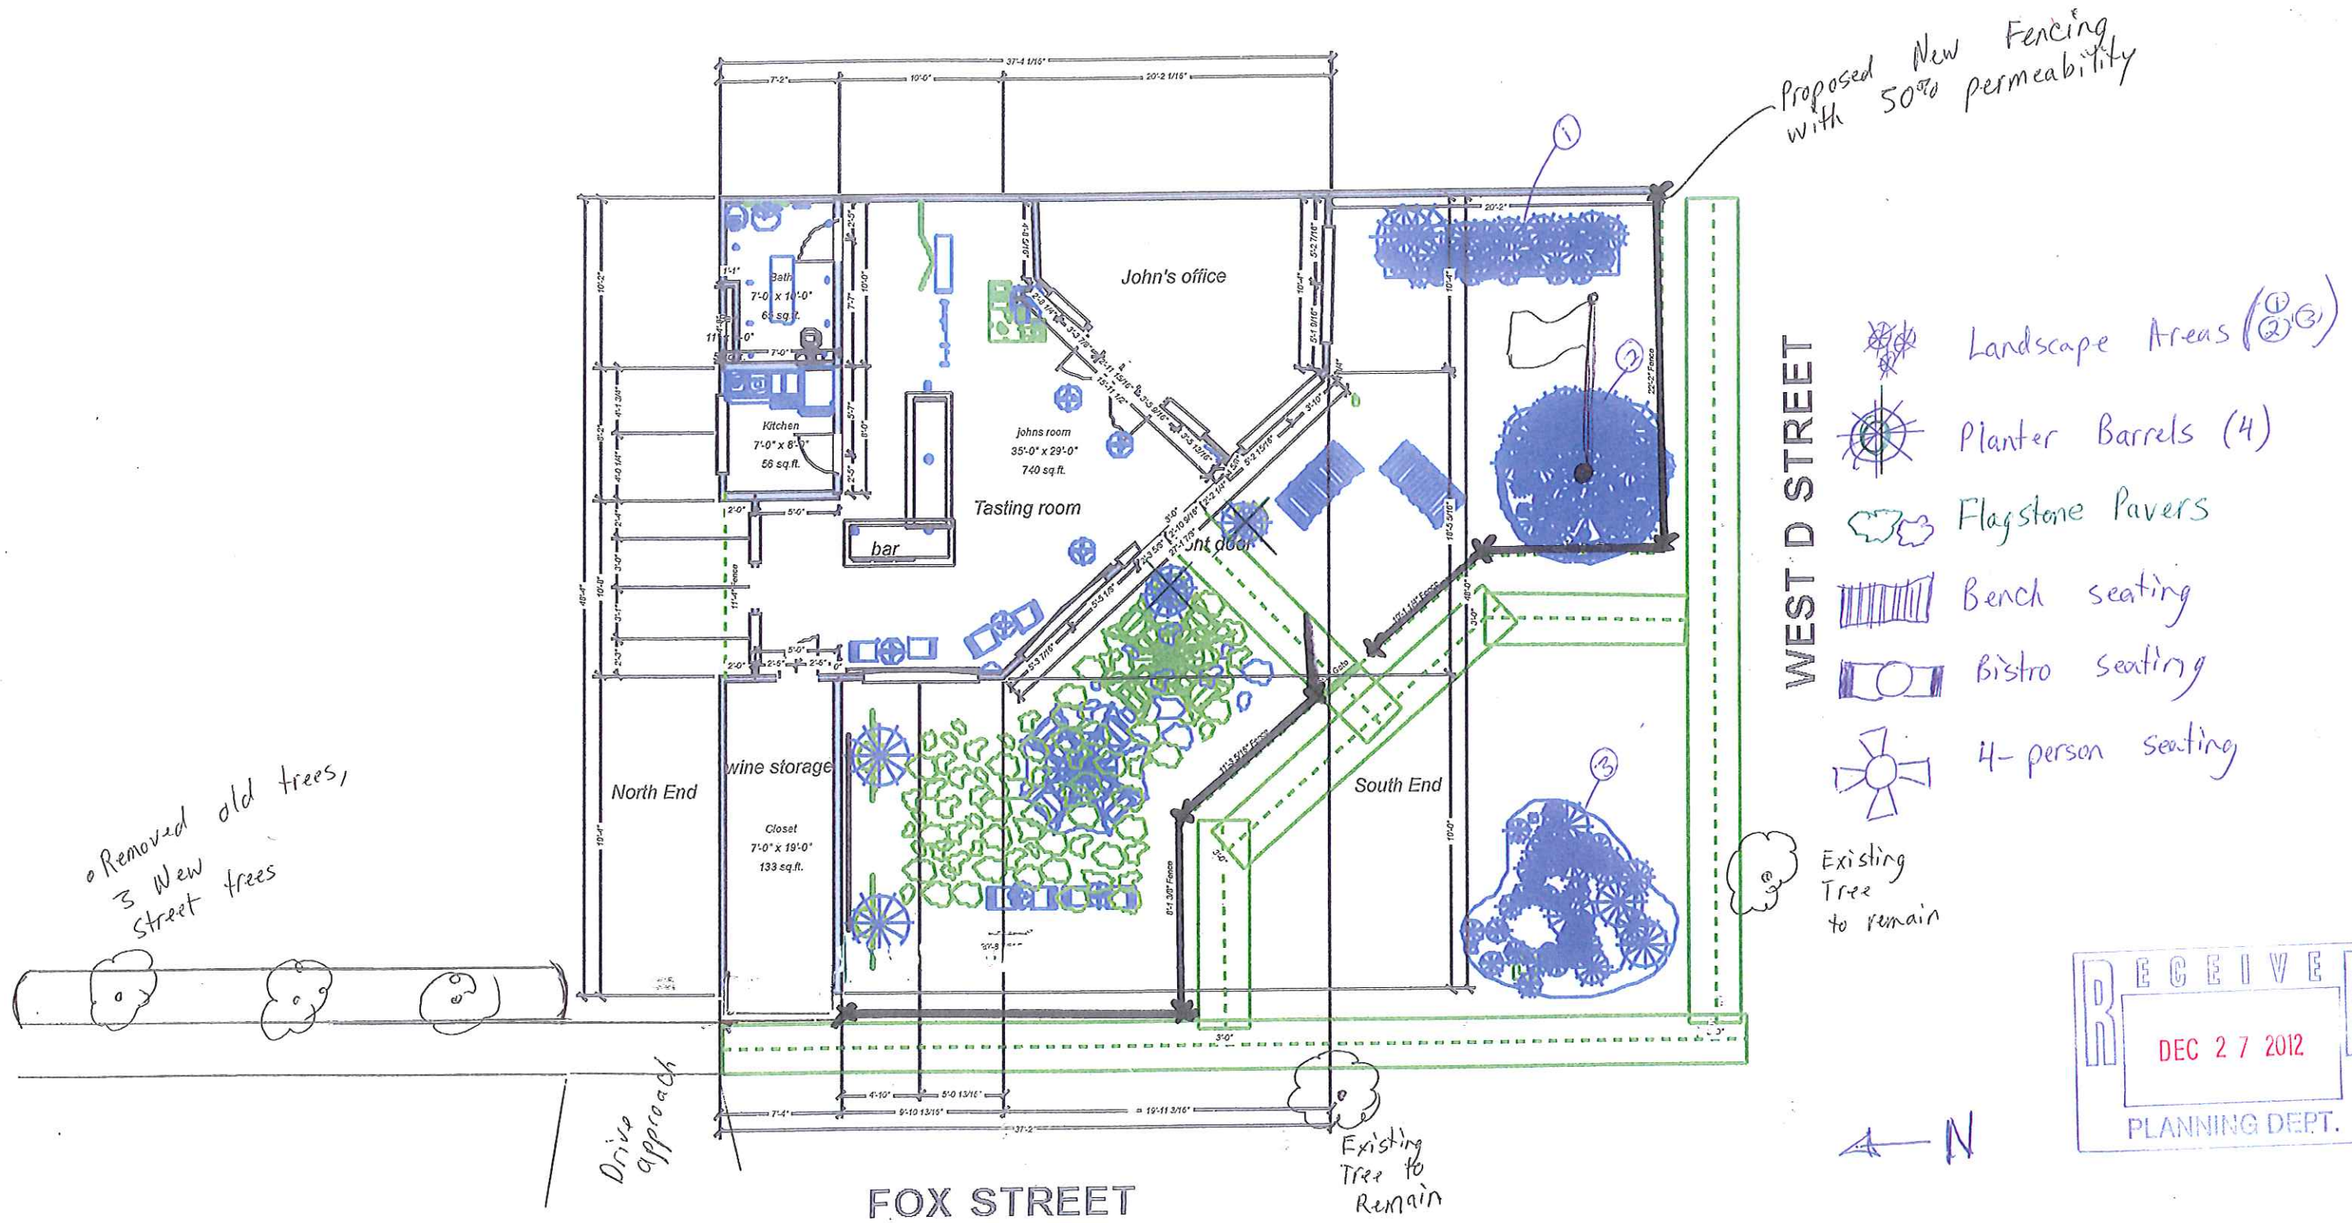

RECEIVED
DEC 27 2012
PLANNING DEPT.

Redlined Site Plan

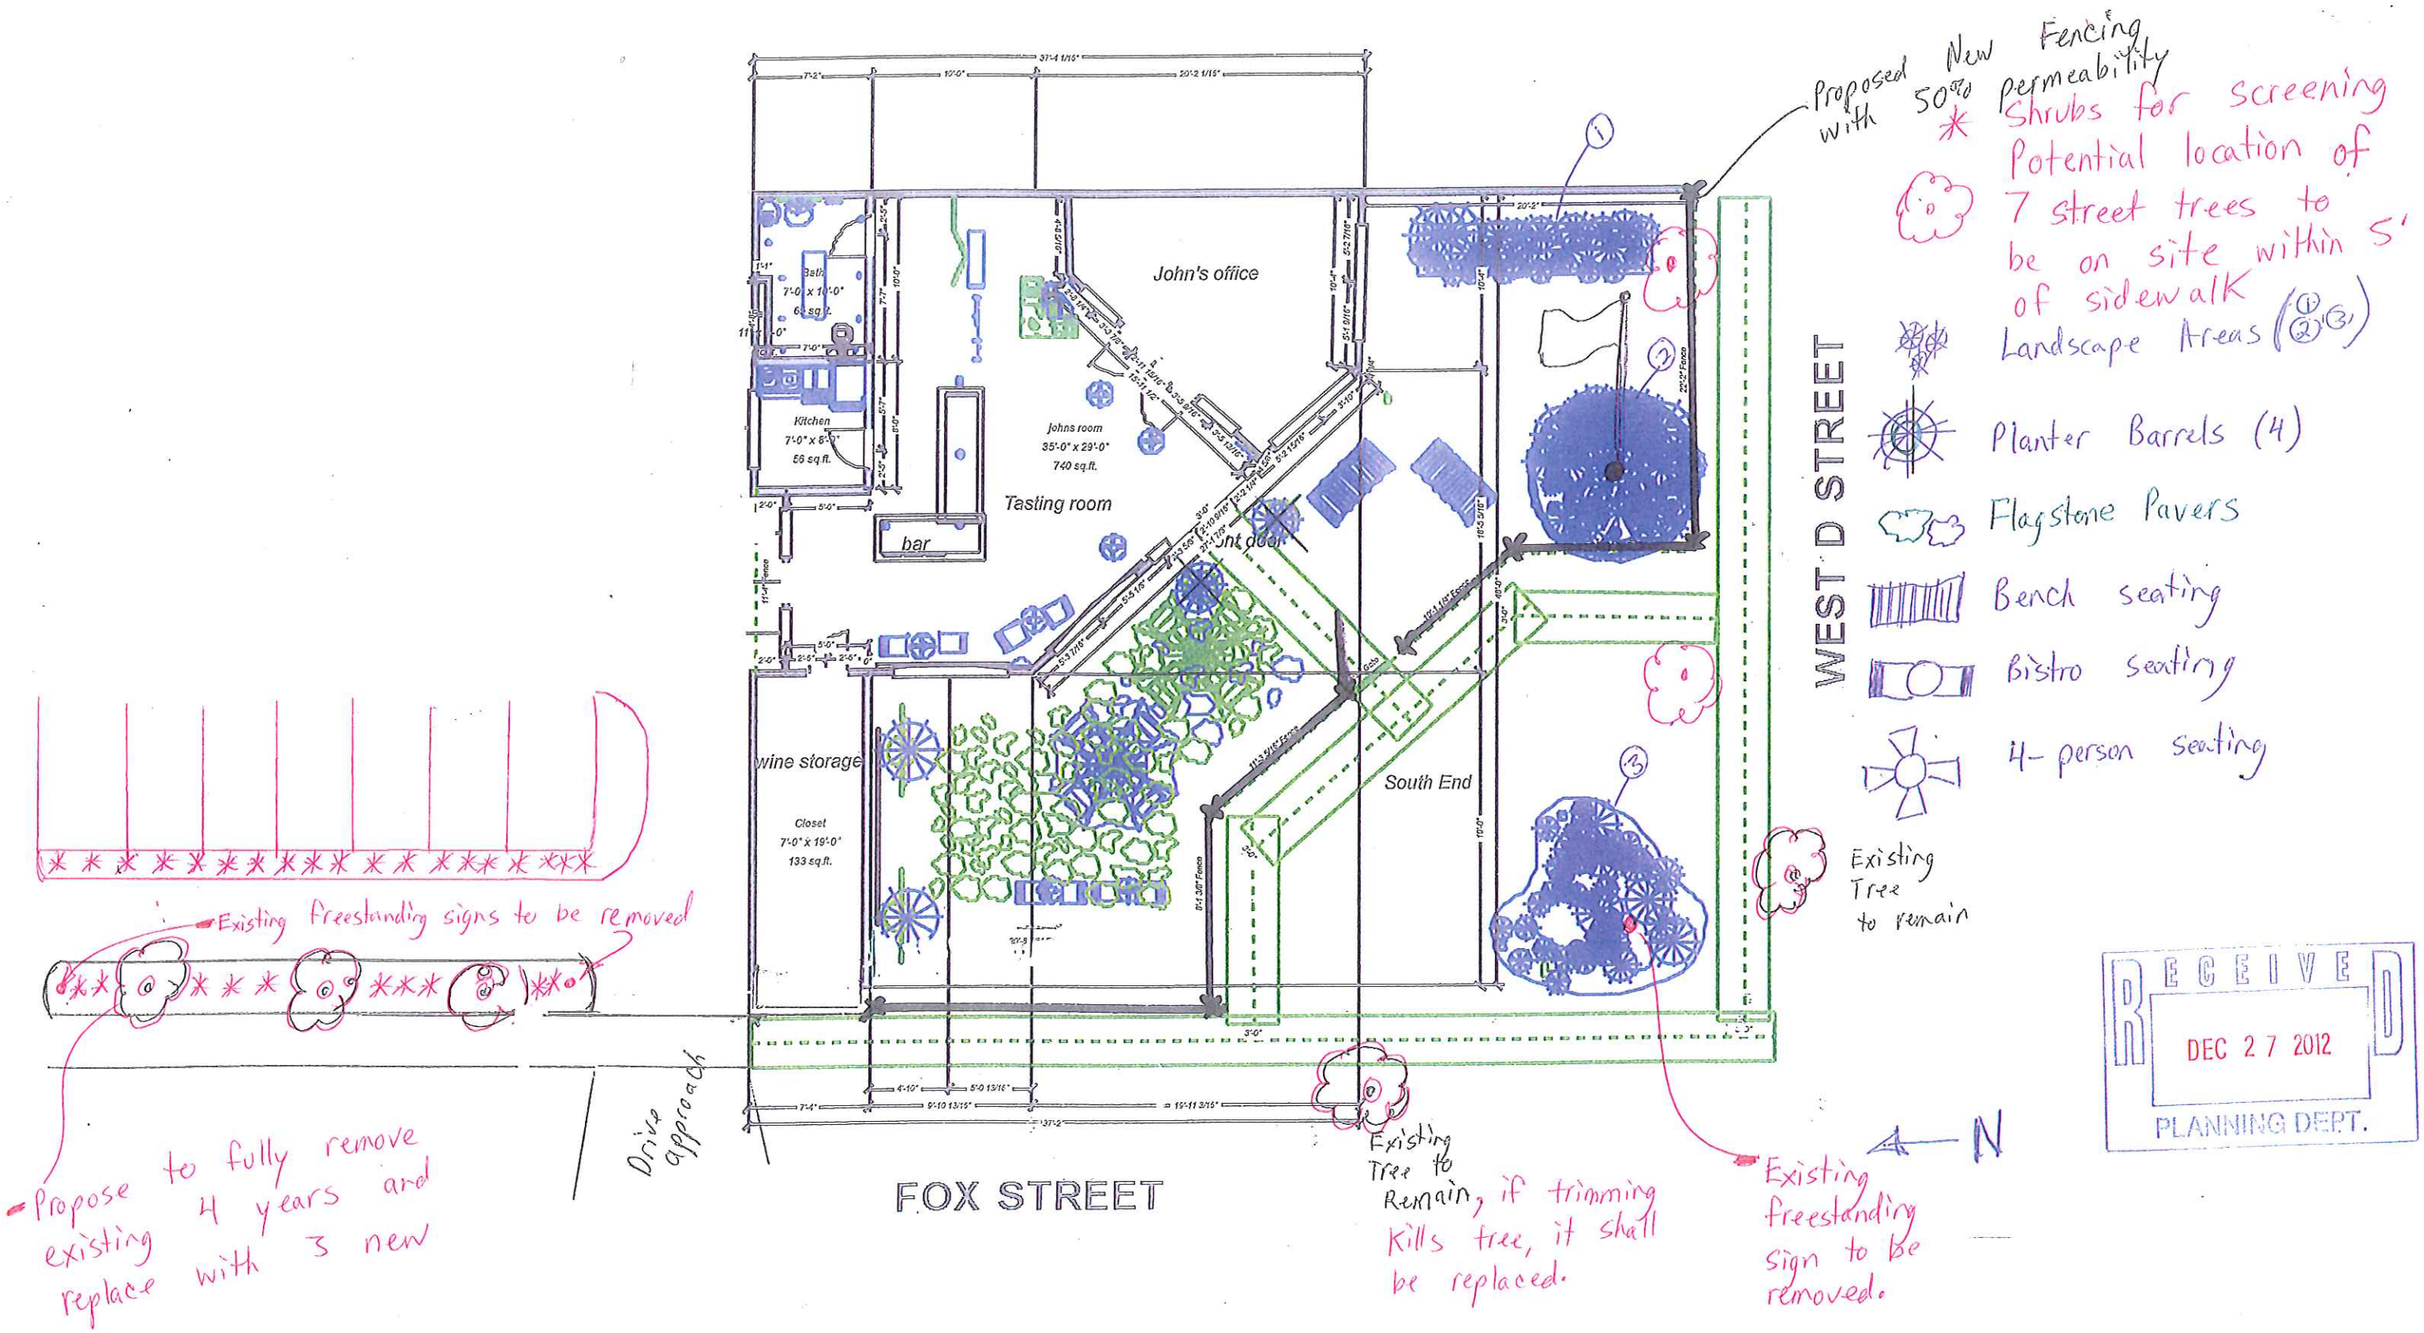

RECEIVED
DEC 27 2012
PLANNING DEPT.